

STATE ENGINEER  
Salem, Oregon

5182  
MARION

# Well Record

STATE WELL NO. 6/3W-24R(1)  
COUNTY Marion  
APPLICATION NO. GR-916

GR- 890

OWNER: Fred Wymore


MAILING ADDRESS: Rt. 2, Box 276

LOCATION OF WELL: Owner's No.

CITY AND STATE: Salem, Oregon

SE 1/4 SE 1/4 Sec. 24 T. 6 S., R. 3 W., W.M.

Bearing and distance from section or subdivision corner 1002' N. & 95' W. from the SE cor. Sec. 24.

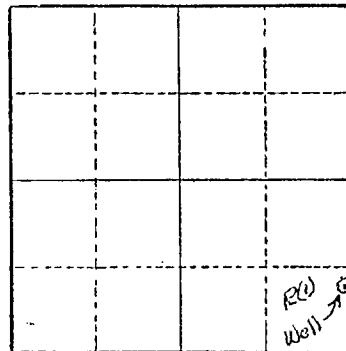

Altitude at well 182 ft.

TYPE OF WELL: Drilled Date Constructed 1953

Depth drilled 130 ft. Depth cased

Section 24

### CASING RECORD:

10 inch

### FINISH:

1/4 in. perforations - 5 to the foot from 100 to 130 ft.

### AQUIFERS:

### WATER LEVEL:

33 ft.

PUMPING EQUIPMENT: Type Ramona Turbine H.P. 7 1/2  
Capacity 130 G.P.M.

### WELL TESTS:

Drawdown 21 ft. after hours 580 G.P.M.  
Drawdown ft. after hours G.P.M.

USE OF WATER Irrigation Temp. °F., 19

SOURCE OF INFORMATION G.R. Record

DRILLER or DIGGER

### ADDITIONAL DATA:

Log Water Level Measurements Chemical Analysis Aquifer Test

### REMARKS:

Log: Top soil 0 to 3 ft.  
 Clay 3 to 33 ft.  
 Water bearing yellow sand 33 to 38 ft.  
 Soft blue shale 38 to 76 ft.  
 Water bearing sand 76 to 85 ft.  
 Little water gravel & shale 85 to 95 ft.  
 Water sand 95 to 99 ft.  
 Water bearing course sand & gravel 99 to 114 ft.  
 Water bearing big size gravel 114 to 130 ft.  
 Irrigation of 19.10 acres.

STATE ENGINEER  
Salem, Oregon

MARI 5/30 Well Record

STATE WELL NO. 6/3W-244(1)  
COUNTY Marion  
APPLICATION NO.

OWNER: Fred Wymore


MAILING ADDRESS:

LOCATION OF WELL: Owner's No.

CITY AND STATE:

..... 1/4 ..... 1/4 Sec. .... T. .... N. E.  
S, R. .... W., W.M.

Bearing and distance from section or subdivision corner

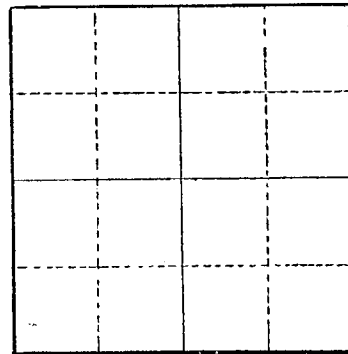

Section .....

Altitude at well ..... 182

TYPE OF WELL: Drilled ..... Date Constructed 1953

Depth drilled 130 ..... Depth cased 130

CASING RECORD:

10 inch

FINISH:

Casing perforated 100 to 130

AQUIFERS:

Gravel from 114 to 130

WATER LEVEL:

33 feet below land surface, August, 1953

PUMPING EQUIPMENT: Type Turbine ..... H.P. 15  
Capacity ..... G.P.M.

WELL TESTS:

Drawdown ..... ft. after ..... hours ..... G.P.M.

Drawdown ..... ft. after ..... hours ..... G.P.M.

USE OF WATER Irrigation--19 acres ..... Temp. .... °F. ...., 19

SOURCE OF INFORMATION USGS

DRILLER or DIGGER

ADDITIONAL DATA:

Log  ..... Water Level Measurements ..... Chemical Analysis ..... Aquifer Test .....

REMARKS:

