

MAR 1950

# Well Record

OWNER: C. A. and Mary F. Petzel


MAILING ADDRESS:

LOCATION OF WELL: Owner's No.

CITY AND STATE: Salem, Oregon

SW 1/4 NW 1/4 Sec. 25 T. 6 N. S, R. 3 E. W., W.M.

Bearing and distance from section or subdivision corner 4 chains East and 8.75 chains North from West 1/4 Corner, Section 25

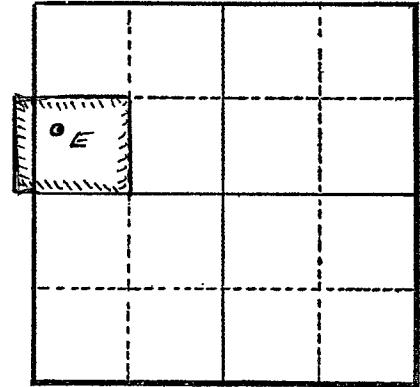

Section 25 feet

Altitude at well 180 feet interpolated

TYPE OF WELL: Drilled Date Constructed May, 1951

Depth drilled 165 feet Depth cased 165 feet

### CASING RECORD:

8-inch steel casing set from 0 to 165 feet

### FINISH:

none

### AQUIFERS:

unk

### WATER LEVEL:

76 feet below land surface June 1950

### PUMPING EQUIPMENT: Type

H.P.

Capacity G.P.M.

### WELL TESTS:

|          |    |           |       |         |     |        |
|----------|----|-----------|-------|---------|-----|--------|
| Drawdown | 15 | ft. after | hours | Pumping | 250 | G.P.M. |
| Drawdown | 21 | ft. after | hours | "       | 450 | G.P.M. |

USE OF WATER Irrigation 50 Temp. °F. 19

SOURCE OF INFORMATION GR-200

DRILLER or DIGGER Irving Sears

### ADDITIONAL DATA:

Log no. Water Level Measurements Chemical Analysis Aquifer Test

### REMARKS: