

STATE ENGINEER
Salem, Oregon

MARI CLAC
52088
02435

Well Record

STATE WELL NO. 7/3W-14R(1)
COUNTY Marion
APPLICATION NO. GR-239

OWNER: Willamette Cherry Growers, Inc. MAILING ADDRESS: 1520 Woodrow Street

LOCATION OF WELL: Owner's No. #1 CITY AND STATE: Salem, Oregon


SE 1/4 SE 1/4 Sec. 14 T. 7 N. S, R. 3 E. W., W.M.

Bearing and distance from section or subdivision corner 780 feet north and 300 feet east from the SW corner of SE 1/4 of Section 14

Altitude at well 160 feet interpolated

TYPE OF WELL: Drilled Date Constructed prior to 1927

Depth drilled 283 1/2 Depth cased 283 1/2

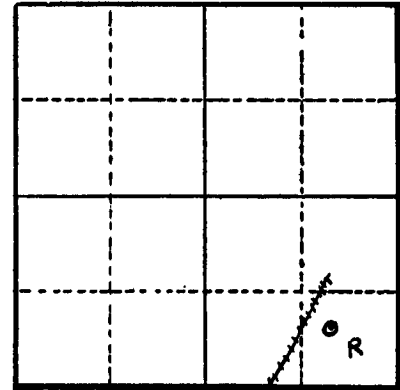

Section 14

CASING RECORD:

8-inch casing set from 0 to 180 feet
6-inch casing set from 180 to 283 1/2 feet

FINISH:

AQUIFERS:

WATER LEVEL:

24 feet below land surface

PUMPING EQUIPMENT: Type Johnson Turbine H.P. 10
Capacity 200 G.P.M.

WELL TESTS:

Drawdown 40 ft. after hours pumping 200 G.P.M.
Drawdown ft. after hours G.P.M.

USE OF WATER manufacturing 200 gpm Temp. °F. 19

SOURCE OF INFORMATION GR-228

DRILLER or DIGGER

ADDITIONAL DATA:

Log no Water Level Measurements Chemical Analysis Aquifer Test

REMARKS: