

STATE ENGINEER  
Salem, Oregon

52/3  
MART. 3

# Well Record


STATE WELL NO. 6/3W-25K(1)  
COUNTY Marion  
APPLICATION NO. GR-356

OWNER: S. E. Swift  
MAILING ADDRESS: 734 North Cottage Street

LOCATION OF WELL: Owner's No. \_\_\_\_\_  
CITY AND STATE: Salem, Oregon

NW 1/4 SE 1/4 Sec. 25 T. 6 N. S., R. 3 E. W., W.M.

Bearing and distance from section or subdivision  
corner 892 feet East and 21 feet South of  
center of Section 25

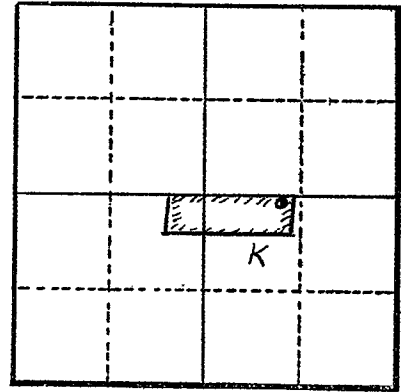

Altitude at well 150 feet

TYPE OF WELL: Drilled Date Constructed Mar. 5, 1951

Depth drilled 10 feet Depth cased \_\_\_\_\_

Section 25

### CASING RECORD:

8-inch I.D.

### FINISH:

### AQUIFERS:

### WATER LEVEL:

29 feet

PUMPING EQUIPMENT: Type Jacuzzi 4" Turbine H.P. 5

Capacity 100 G.P.M.

### WELL TESTS:

Drawdown \_\_\_\_\_ ft. after \_\_\_\_\_ hours \_\_\_\_\_ G.P.M.

Drawdown \_\_\_\_\_ ft. after \_\_\_\_\_ hours \_\_\_\_\_ G.P.M.

USE OF WATER Irrigation Temp. \_\_\_\_\_ °F. \_\_\_\_\_, 19\_\_\_\_\_

SOURCE OF INFORMATION GR-346

DRILLER or DIGGER Max Wymore

### ADDITIONAL DATA:

Log no. \_\_\_\_\_ Water Level Measurements \_\_\_\_\_ Chemical Analysis \_\_\_\_\_ Aquifer Test \_\_\_\_\_

### REMARKS: