

STATE OF OREGON
MONITORING WELL REPORT
(as required by ORS 537.765 & OAR 690-240-095)

Instructions for completing this report are on the last page of this form.

DEC 2 1997 MARI 52636

Start Card # 59855

(1) OWNER/PROJECT: WELL NO. Park well #1
Name City of Salem
Address 555 Liberty St. S.E.
City Salem State OR Zip 97301

(2) TYPE OF WORK:


- ☐ New construction ☐ Alteration (Repair/Recondition)
☒ Conversion ☐ Deepening ☐ Abandonment

(3) DRILLING METHOD

- ☒ Rotary Air ☐ Rotary Mud ☐ Cable
☐ Hollow Stem Auger ☐ Other

(4) BORE HOLE CONSTRUCTION

Special Standards Yes ☐ No ☒ Depth of completed well 305 ft.

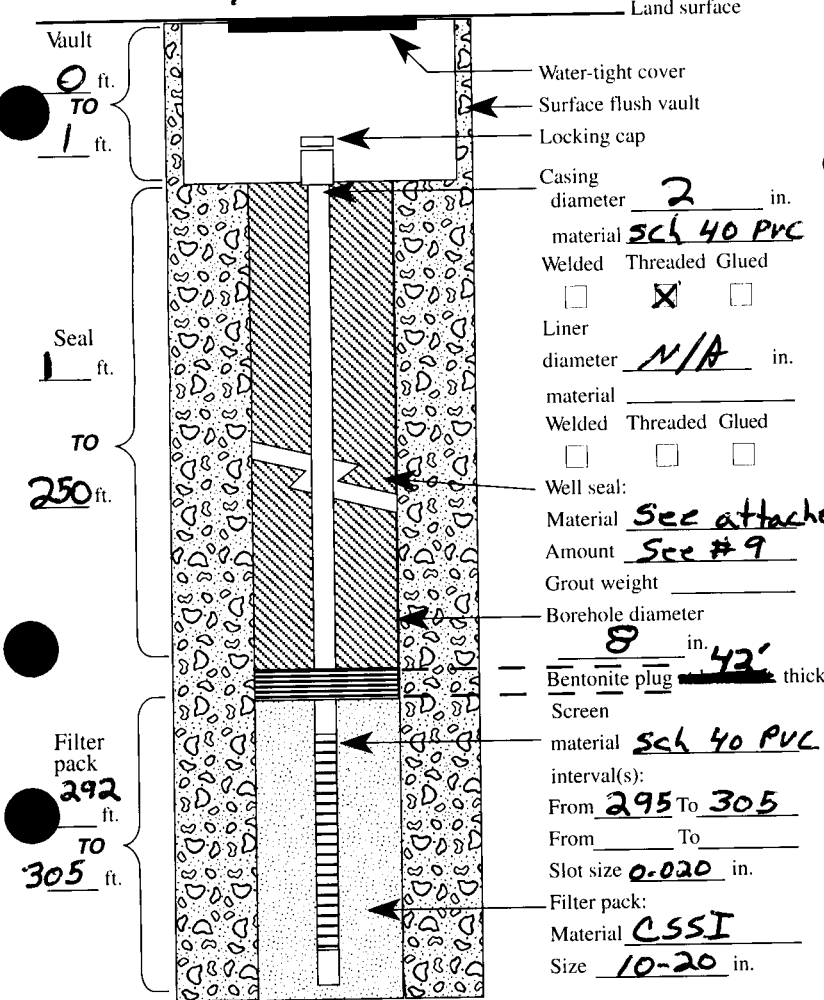

(6) LOCATION OF WELL By legal description

Well Location: County Marion
Township 8S (N or S) Range 3W (E or W) Section 10
1. S.W. 1/4 of S.E. 1/4 of above section.
2. Either Street address of well location Woodmansee Park
South Salem OR
or Tax lot number of well location N/A

3. ATTACH MAP WITH LOCATION IDENTIFIED. Map shall include approximate scale and north arrow.

(7) STATIC WATER LEVEL:

199.58 Ft. below land surface. Date 1-30-95
Artesian Pressure _____ lb/sq. in. Date _____

(8) WATER BEARING ZONES:

Depth at which water was first found See original

From	To	Est. Flow Rate	SWL
See original			

(9) WELL LOG:

Ground elevation **RECEIVED**

Material	From	To	SWL
original 8" well drilled in 1954			
to 291.8' 8" steel casing to 104'			
This well was deepened to 315' and converted to one 2" PVC monitoring			
perforated from ground level to 104'			
See attachments for original well log and new construction details			
Seal materials			
Cement 6 sacks			
Puregold grout 96 sacks			
bent chips 39 sacks			

Date started 1-24-95 Completed 1-30-95

(unbonded) Monitor Well Constructor Certification:

I certify that the work I performed on the construction, alteration, or abandonment of this well is in compliance with Oregon well construction standards. Materials used and information reported above are true to the best knowledge and belief.

MWC Number 10330

Signed Steve Zimmerman Date _____

(bonded) Monitor Well Constructor Certification:

I accept responsibility for the construction, alteration, or abandonment work performed on this well during the construction dates reported above. All work performed during this time is in compliance with Oregon well construction standards. This report is true to the best of my knowledge and belief.

MWC Number 10096

Signed John R. Stoltz Date 11-28-97

(5) WELL TEST: See original attachments

☐ Pump ☐ Bailer ☐ Air ☐ Flowing Artesian
Permeability _____ Yield _____ GPM
Conductivity 548 PH _____
Temperature of water 77.4 °F/C Depth artesian flow found _____ ft.
Was water analysis done? ☐ Yes ☒ No
By whom? _____
Depth of strata to be analyzed. From _____ ft. to _____ ft.
Remarks: _____

Name of supervising Geologist/Engineer Mike Klisch

ORIGINAL & FIRST COPY-WATER RESOURCES DEPARTMENT

SECOND COPY-CONSTRUCTOR THIRD COPY-CUSTOMER



Oregon Water Resources Department
 725 Summer Street NE, Suite A
 Salem Oregon 97301
 (503) 986-0900
 www.wrd.state.or.us

Application for Well ID Number

RECEIVED BY OWRD

Do not complete if the well already has a Well I.D Number.

SEP 27 2012

I. OWNER INFORMATION

Current Owner Name (please print): City of Salem **SALEM, OR**
 Mailing Address: 555 Liberty Street SE
 City: Salem State: Oregon Zip: 97301
 Mailing Address (to send Well I.D.): Lacey Goeres, City of Salem Public Works Dept, 1410 20th Street SE, Bldg 2
 City: Salem State: Oregon Zip: 97302

II. WELL INFORMATION (Do not complete this section if the well report is attached.)

City of Salem Park Well 1

Township: 8 South (North/South) Range: 3 West (East/West) Section: 10
 Tax Lot: 083W10DB00900 County: Marion NW 1/4 SE 1/4
 Street Address of Well: Woodmansee Park, 4629 Sunnyside Road SE City: Salem
 Owner at time the well was constructed, (if known): City of Salem
 If the property had a different street address in the past: N/A

III. GENERAL WELL INFORMATION (Do not complete this section if the well report is attached)

MARI 11677 & 52656

Use of Well (domestic, irrigation, commercial, industrial, monitoring): _____
 Date Well Constructed: _____ Total Well Depth: _____ Casing Diameter: _____
 Other Information: _____

SUBMITTED BY (please print): Lacey Goeres
 PHONE: 503.361.2224 FAX: 503.588.6480

RECEIVED BY OWRD

SEP 27 2012

SALEM, OR

Send application to Oregon Water Resources Department; 725 Summer St NE, Suite A; Salem, Oregon 97301-1266; fax (503) 986-0902. Applications are processed and Well I.D. Numbers are mailed every Wednesday.

For Official Use Only by the Oregon Water Resources Department:

Received Date:

9.27.12

Well Log Number:

MARI 11677

Well Identification #:

L 82686

MARI 52656