

STATE ENGINEER  
Salem, Oregon

5281  
MARI...

# Well Record

STATE WELL NO. 6/3W-26B  
COUNTY Marion  
APPLICATION NO. GR-2077

OWNER: Walter S. Franklin  
MAILING ADDRESS: 1840 Barnick Road NE

LOCATION OF WELL: Owner's No. CITY AND STATE: Salem, Oregon


NW 1/4 NE 1/4 Sec. 26 T. 6 N. S., R. 3 E. W., W.M.

Bearing and distance from section or subdivision corner 168 feet South and 36 feet East

Altitude at well

TYPE OF WELL: Drilled Date Constructed 1954

Depth drilled 105 feet Depth cased 105 feet

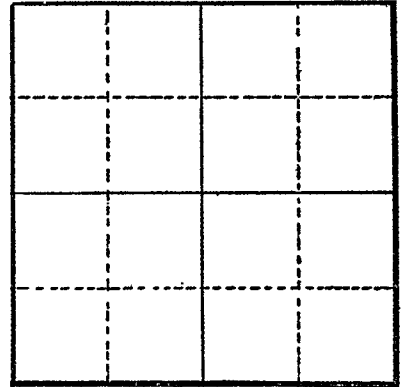

Section

### CASING RECORD:

6-inch

### FINISH:

Perforations from 88 to 101

### AQUIFERS:

sand and gravel

### WATER LEVEL:

65 feet

PUMPING EQUIPMENT: Type Fairbanks Morse - Jet H.P. 2

Capacity 100 G.P.M.

### WELL TESTS:

Drawdown 26 ft. after hours Pumping 115 G.P.M.

Drawdown ft. after hours G.P.M.

USE OF WATER Irrigation Temp. °F., 19

SOURCE OF INFORMATION GR-1996

DRILLER or DIGGER Harvey Evens, Clear Lake, Salem, Oregon

### ADDITIONAL DATA:

Log  Water Level Measurements Chemical Analysis Aquifer Test

### REMARKS:

- gravel 85 to 88
- sand 88 to 98
- gravel 98 to 101
- gravel and rock 101 to 105