

STATE ENGINEER  
Salem, Oregon

# Well Record

STATE WELL NO. 6/3W-260(1)  
COUNTY Marion  
APPLICATION NO. GR-1537

5283  
MAR 1947

GR- 1480

OWNER: Orin E. Lang


MAILING ADDRESS: 7596 Wheatland Rd.

LOCATION OF WELL: Owner's No.

CITY AND STATE: Salem, Oregon

NE 1/4 NW 1/4 Sec. 26 T. 6 S., R. 3 W., W.M.

Bearing and distance from section or subdivision corner 1020' W. & 580' S. from N 1/4 cor. Sec. 26

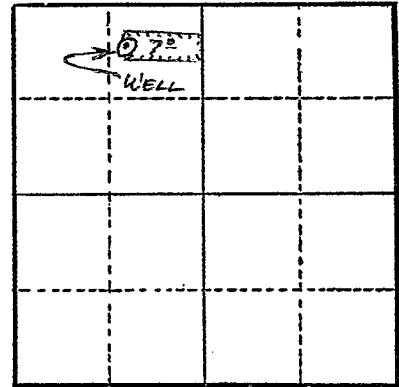

Section 26

Altitude at well 171' ? 182'

TYPE OF WELL: Drilled Date Constructed 1947

Depth drilled 93' Depth cased 93'

### CASING RECORD:

6" OD

### FINISH:

### AQUIFERS:

### WATER LEVEL:

50'

PUMPING EQUIPMENT: Type Berkeley turbine H.P. 5

Capacity 50 G.P.M.

### WELL TESTS:

Drawdown 40? ft. after 35 hours G.P.M.

Drawdown ft. after hours G.P.M.

USE OF WATER Irrigation Temp. °F. 19

SOURCE OF INFORMATION GR Record

DRILLER or DIGGER H. E. Evans

### ADDITIONAL DATA:

Log N.A. Water Level Measurements Chemical Analysis Aquifer Test

### REMARKS:

Irrigation of 7 acres.