

STATE ENGINEER
Salem, Oregon

5284
MARI...

Well Record

STATE WELL NO. 6/3W-26C (2)
COUNTY Marion
APPLICATION NO. GR-1556

GR- 1500

OWNER: Leonard E. Nelson


MAILING ADDRESS: 7590 Wheatland Rd.

LOCATION OF WELL: Owner's No.

CITY AND STATE: Salem, Oregon

NE 1/4 NW 1/4 Sec. 26 T. 6 S. R. 3 W., W.M.

Bearing and distance from section or subdivision corner 672' S. & 787' W. from N 1/4 cor. Sec. 26.

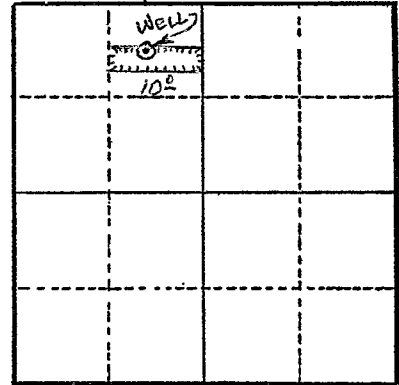

Section 26

Altitude at well 180' ? 182'

TYPE OF WELL: Drilled Date Constructed 1952

Depth drilled 116' Depth cased 116'

CASING RECORD:
8"

FINISH:
Perforated from 105 to 116 ft.

AQUIFERS:

WATER LEVEL:
65'

PUMPING EQUIPMENT: Type Berkeley turbine 5 stage H.P. 5
Capacity 90 G.P.M.

WELL TESTS:
Drawdown 9 ft. after 125 hours G.P.M.
Drawdown 25 ft. after 300 hours G.P.M.

USE OF WATER Irrigation Temp. °F. 19

SOURCE OF INFORMATION GR Record

DRILLER or DIGGER Fred Wymore

ADDITIONAL DATA:
Log Water Level Measurements Chemical Analysis Aquifer Test

REMARKS:

Log:	Top soil & ???	0 to 80 ft.
	Clay & gravel	80 to
	Sand & gravel	to 95 ft.
	Gravel	95 to 116 ft.

Irrigation of 10 acres.