

STATE ENGINEER
Salem, Oregon

5286
MARI.....

Well Record

GR- 1415

STATE WELL NO. 6/3W-26D(1)
COUNTY Marion
APPLICATION NO. GR- 1466

OWNER: Walter Oldenburg


MAILING ADDRESS: 7595 Wheatland Rd.

LOCATION OF WELL: Owner's No.

CITY AND STATE: Salem, Oregon

NW 1/4 NW 1/4 Sec. 26 T. 6 S. R. 3 W., W.M.

Bearing and distance from section or subdivision corner 594' S. & 16' E. from NE cor. of Alvis Smith DIC

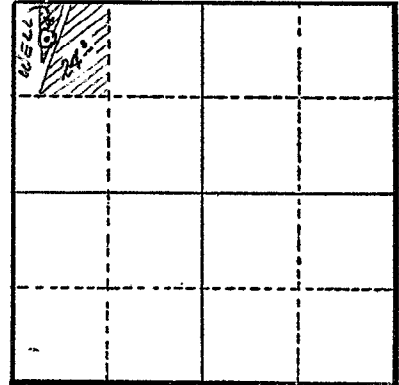

Section 26

Altitude at well 180' 125'

TYPE OF WELL: Drilled Date Constructed 1947

Depth drilled 115' Depth cased 115'

CASING RECORD:

10"

FINISH:

Mills knife perforations from 50' to 54'
" " " " " 60' to 65'

AQUIFERS:

WATER LEVEL:

15'

PUMPING EQUIPMENT: Type Cornell 2" x 2 1/2" Cent. H.P. 10

Capacity 200 G.P.M.

WELL TESTS:

Drawdown ft. after hours G.P.M.

Drawdown ft. after hours G.P.M.

USE OF WATER Irrigation Temp. °F. 19

SOURCE OF INFORMATION GR Record

DRILLER or DIGGER H. E. Evans

ADDITIONAL DATA:

Log N. A. Water Level Measurements Chemical Analysis Aquifer Test

REMARKS:

Irrigation of 24 acres.