

STATE ENGINEER
Salem, Oregon

MARI. 5294

Well Record


STATE WELL NO. 6/3W-26F(1)
COUNTY Marion
APPLICATION NO. GR-767

OWNER: John L. Schmaltz
MAILING ADDRESS: 7450 Wheatland Road

LOCATION OF WELL: Owner's No.
CITY AND STATE: Salem, Oregon

SE 1/4 NW 1/4 Sec. 26 T. 6 N. S. R. 3 E. W., W.M.

Bearing and distance from section or subdivision
corner 2200 feet East and 1400 feet South
from NW Corner, Section 26

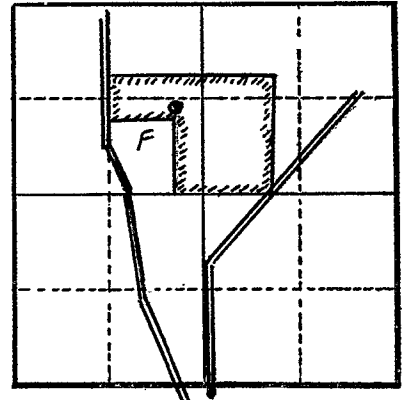

Section 26

Altitude at well

TYPE OF WELL: Drilled Date Constructed Mar. 1953

Depth drilled 118 feet Depth cased 118 feet

CASING RECORD:

10-inch steel from 0 to 118 feet

FINISH:

Perforated 71 to 118 feet

AQUIFERS:

WATER LEVEL:

65 feet

PUMPING EQUIPMENT: Type H.P.

Capacity G.P.M.

WELL TESTS:

Drawdown 18 ft. after 290 hours G.P.M.

Drawdown ft. after hours G.P.M.

USE OF WATER Irrigation Temp. °F., 19

SOURCE OF INFORMATION GR-742

DRILLER or DIGGER Sneed Bors.

ADDITIONAL DATA:

Log Water Level Measurements Chemical Analysis Aquifer Test

REMARKS:

top soil and clay	0	40	40
sand	40	50	10
sand and gravel, course	50	118	68