

STATE ENGINEER
Salem, Oregon

5295
M 21... Well Record

STATE WELL NO. 6/3W-26H(1)
COUNTY Marion
APPLICATION NO. GR-60

OWNER: Clifford and Grace Lindquist

MAILING
ADDRESS:

LOCATION OF WELL: Owner's No.

CITY AND
STATE:


Salem, Oregon

SE 1/4 NE 1/4 Sec. 26 T. 6 N. S. R. 3 W., W.M.

Bearing and distance from section or subdivision

corner 16 chains West and 7 1/2 chains North of

E 1/4 Corner between Sections 25 and 26

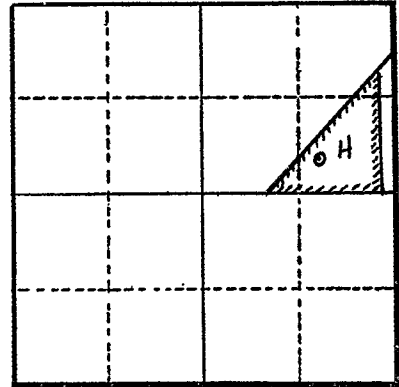

Section 26

Altitude at well 180 feet interpolated

TYPE OF WELL: Drilled Date Constructed Feb. 1951

Depth drilled 92 feet Depth cased 92 feet

CASING RECORD:

8-inch casing set from 0 to 92 feet

FINISH:

none

AQUIFERS:

WATER LEVEL:

72 feet below land surface Feb. 1951 48.87 (3-11-60)

PUMPING EQUIPMENT: Type Jacuzzi Jet 2 1/2 x 3" H.P. 5
Capacity 150 G.P.M.

WELL TESTS:

Drawdown 14 ft. after 100 hours G.P.M.
Drawdown 18 ft. after 150 hours G.P.M.

USE OF WATER Dom. & Irrigation 25 Temp. °F. 19

SOURCE OF INFORMATION GR-52

DRILLER or DIGGER Irving Sears Gervais, Oregon

ADDITIONAL DATA:

Log no. Water Level Measurements Chemical Analysis Aquifer Test

REMARKS: