

STATE ENGINEER
Salem, Oregon

MARI... 5297

Well Record

STATE WELL NO. 6/3W-26L(1)
COUNTY Marion
APPLICATION NO. GR-162

OWNER: Pete Taranoff


MAILING ADDRESS: Newberg, St. Paul Hwy.

LOCATION OF WELL: Owner's No.

CITY AND STATE: Salem, Oregon

NE 1/4 SW 1/4 Sec. 26 T. 6 N. S. R. 3 E. W.M.

Bearing and distance from section or subdivision corner

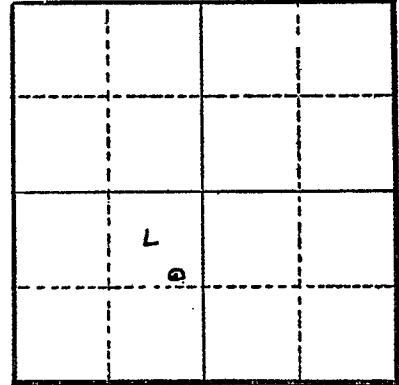

Section 26

Altitude at well 350 feet interpolated

TYPE OF WELL: Drilled Date Constructed 5-12-52

Depth drilled 110 feet Depth cased 110 feet

CASING RECORD:

10-inch casing set from 0 to 110 feet

FINISH:

none

AQUIFERS:

no record

WATER LEVEL:

56 feet below land surface

PUMPING EQUIPMENT: Type Jacuzzi Turbine H.P. 15

Capacity 250 G.P.M.

WELL TESTS:

Drawdown 97 ft. after hours Pumping 300 G.P.M.

Drawdown ft. after hours G.P.M.

USE OF WATER Irrigation 10 Temp. °F. 19

SOURCE OF INFORMATION GR-155

DRILLER or DIGGER Fred Wymore Route 2, Box 317, Salem, Oregon

ADDITIONAL DATA:

Log no Water Level Measurements Chemical Analysis Aquifer Test

REMARKS: