

STATE ENGINEER  
Salem, Oregon

5298  
MAR 1953

# Well Record

STATE WELL NO. 6/3W-26M(1)  
COUNTY Marion  
APPLICATION NO. GR-1203

GR- 1163


OWNER: Floyd E. & Wilma G. Springer

MAILING ADDRESS: 7175 Wheatland Rd.

LOCATION OF WELL: Owner's No.

CITY AND STATE: Salem, Oregon

NW 1/4 SW 1/4 Sec. 26 T. 6 S, R. 3 W, W.M.

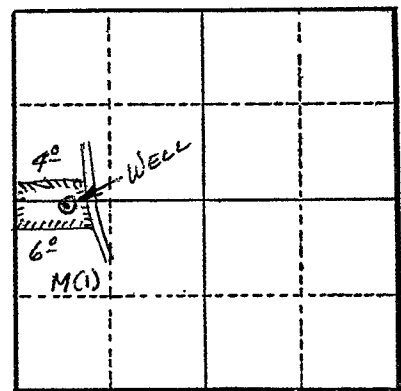

Bearing and distance from section or subdivision

corner 40' S. & 700' E. of W 1/4 cor. of Sec. 26/

Altitude at well 180 ft.

TYPE OF WELL: Drilled Date Constructed 1953

Depth drilled 123 ft. Depth cased 123 ft.

Section 26

### CASING RECORD:

8 inch

### FINISH:

Perforated ??

### AQUIFERS:

### WATER LEVEL:

70 ft.

PUMPING EQUIPMENT: Type Universal submersible H.P. 5

Capacity 120 G.P.M.

### WELL TESTS:

Drawdown ft. after hours G.P.M.

Drawdown ft. after hours G.P.M.

USE OF WATER Irrigation Temp. °F., 19

SOURCE OF INFORMATION G. R. Record

DRILLER or DIGGER Wymore

### ADDITIONAL DATA:

Log N.A. Water Level Measurements Chemical Analysis Aquifer Test

### REMARKS:

Irrigation of 10 acres.