

STATE ENGINEER
Salem, Oregon

5309
MAR... Well Record


STATE WELL NO. 6/3W-27M
COUNTY Marion
APPLICATION NO. 3278
6-7306

OWNER: Clifford F. Gray MAILING ADDRESS: 7095 Wheatland Road
CITY AND STATE: Salem, Oregon

Pg 1 of 2

LOCATION OF WELL: Owner's No. _____
NW 1/4 SW 1/4 Sec. 27 T. 6 S. R. 3 W., W.M.

Bearing and distance from section or subdivision
corner 1202.2' E. & 1500' N. from SW cor. Sec. 27

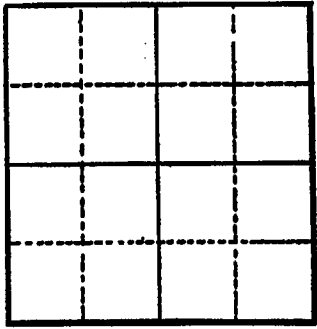

Altitude at well _____

TYPE OF WELL: drilled Date Constructed 1954
Depth drilled 65 Depth cased 65

Section _____

CASING RECORD:

12 inch

FINISH:

AQUIFERS:

WATER LEVEL:
10 feet

PUMPING EQUIPMENT: Type Cornell Centrifugal H.P. 30
Capacity 700 G.P.M.

WELL TESTS:
Drawdown 17 ft. after _____ hours Pumping 700 G.P.M.
Drawdown _____ ft. after _____ hours _____ G.P.M.

USE OF WATER Irrigation Temp. _____ °F. _____, 19____

SOURCE OF INFORMATION GR-3047
DRILLER or DIGGER Harvey Evans

ADDITIONAL DATA:
Log _____ Water Level Measurements _____ Chemical Analysis _____ Aquifer Test _____

REMARKS:

STATE ENGINEER
Salem, Oregon

5309
M 101

Well Record

STATE WELL NO. 6/3W-27M(1)
COUNTY Marion
APPLICATION NO.

g 2 of 2

OWNER: C. F. Orey

MAILING ADDRESS:

LOCATION OF WELL: Owner's No.

CITY AND STATE:

¼ Sec. T. N. S., R. E. W., W.M.

Bearing and distance from section or subdivision corner

Altitude at well 121

TYPE OF WELL: Drilled Date Constructed 1954

Depth drilled 65 Depth cased

Section

CASING RECORD:

12 inch

FINISH:

AQUIFERS:

WATER LEVEL:

PUMPING EQUIPMENT: Type Centrifugal H.P. 30
Capacity G.P.M.

WELL TESTS:

Drawdown ft. after hours G.P.M.
Drawdown ft. after hours G.P.M.

USE OF WATER Irrigation--50 acres Temp. °F. 19

SOURCE OF INFORMATION USGS

DRILLER or DIGGER

ADDITIONAL DATA:

Log Water Level Measurements Chemical Analysis Aquifer Test

REMARKS: