

STATE ENGINEER
Salem, Oregon

MARI 5310
Well Record

STATE WELL NO. 6/3W-27M(1)
COUNTY Marion
APPLICATION NO.

OWNER: C. F. Orey


MAILING ADDRESS:

LOCATION OF WELL: Owner's No.

CITY AND STATE:

1/4 1/4 Sec. T. N. E. S, R. W., W.M.

Bearing and distance from section or subdivision corner

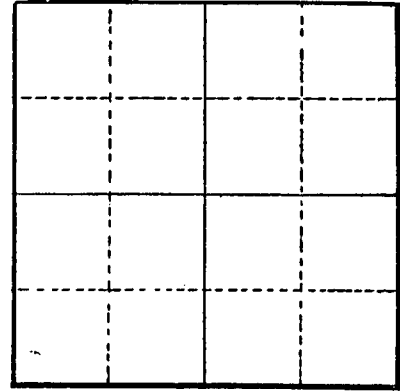

Section

Altitude at well 121

TYPE OF WELL: Drilled Date Constructed 1954

Depth drilled 65 Depth cased

CASING RECORD:

12 inch

FINISH:

AQUIFERS:

WATER LEVEL:

PUMPING EQUIPMENT: Type Centrifugal H.P. 30
Capacity G.P.M.

WELL TESTS:

Drawdown ft. after hours G.P.M.
Drawdown ft. after hours G.P.M.

USE OF WATER Irrigation--50 acres Temp. °F., 19

SOURCE OF INFORMATION USGS

DRILLER or DIGGER

ADDITIONAL DATA:

Log Water Level Measurements Chemical Analysis Aquifer Test

REMARKS: