

STATE ENGINEER
Salem, Oregon

MARI... 5330

Well Record

STATE WELL NO. 6/3W-28A(1)
COUNTY Marion
APPLICATION NO. GR-368

OWNER: Earl & Hazel Weathers


MAILING ADDRESS: Route 2, Box 77

LOCATION OF WELL: Owner's No. 3

CITY AND STATE: Salem, Oregon

NE 1/4 NE 1/4 Sec. 28 T. 6 N. S., R. 3 E. W., W.M.

Bearing and distance from section or subdivision corner 1000 feet West and 510 feet South from NE Corner, Section 28

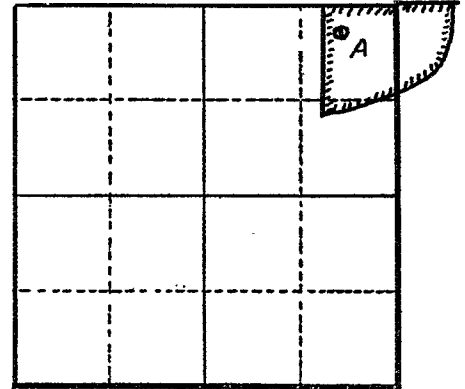

Section 28

Altitude at well 90 feet

TYPE OF WELL: Drilled Date Constructed 1946

Depth drilled 46 feet Depth cased _____

CASING RECORD:

10-inch

FINISH:

AQUIFERS:

WATER LEVEL:

11 feet 10.1 (1-13-60)

PUMPING EQUIPMENT: Type Berkeley Turbine H.P. 30

Capacity 500 G.P.M.

WELL TESTS:

Drawdown _____ ft. after _____ hours _____ G.P.M.

Drawdown _____ ft. after _____ hours _____ G.P.M.

USE OF WATER Irrigation Temp. _____ °F. _____, 19_____

SOURCE OF INFORMATION GR-354

DRILLER or DIGGER _____

ADDITIONAL DATA:

Log x Water Level Measurements _____ Chemical Analysis _____ Aquifer Test _____

REMARKS:

Moist dirt 0 to 18 feet
Gravel 18 to 46 feet