

STATE ENGINEER
Salem, Oregon

5335
MARI. 35

Well Record

STATE WELL NO. 6/3W-28C
COUNTY Marion
APPLICATION NO. GR-1517

GR- 1465

OWNER: D. F. Kennedy


MAILING ADDRESS: Rt. 1

LOCATION OF WELL: Owner's No. #1

CITY AND STATE: Independence, Oregon

NE 1/4 NW 1/4 Sec. 28 T. 6 S., R. 3 W., W.M.

Bearing and distance from section or subdivision corner 1950' E. & 75' S. from NW cor. Sec. 28.

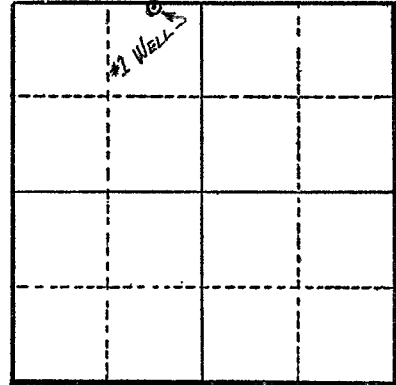

Section 28

Altitude at well 120'

TYPE OF WELL: Drilled Date Constructed 1950

Depth drilled 35' Depth cased 32'

CASING RECORD:

12" screw casing from 0 to 32 ft.

FINISH:

Torch cutting perforations from 17 to 32 ft.

AQUIFERS:

WATER LEVEL:

12'

PUMPING EQUIPMENT: Type Cent. H.P. 40

Capacity 750 G.P.M.

WELL TESTS:

Drawdown 6 ft. after 750 G.P.M.

Drawdown ft. after hours G.P.M.

USE OF WATER Irrigation Temp. °F. 19

SOURCE OF INFORMATION GR Record

DRILLER or DIGGER

ADDITIONAL DATA:

Log Water Level Measurements Chemical Analysis Aquifer Test

REMARKS:

Log: Sandy loam 0 to 10 ft.
Sand & gravel 10 to 17 ft.
Gravel 17 to 32 ft.

Irrigation of 78 acres.