

STATE ENGINEER  
Salem, Oregon

# Well Record

STATE WELL NO. 6/3W-28E  
COUNTY Marion  
APPLICATION NO. GR-1519

MARI...  
\$336

GR- 1467

OWNER: D. F. Kennedy


MAILING ADDRESS: Rt. 1

LOCATION OF WELL: Owner's No. #3

CITY AND STATE: Independence, Oregon

SW 1/4 NW 1/4 Sec. 28 T. 6 S., R. 3 W., W.M.

Bearing and distance from section or subdivision corner 1250' E. & 1400' S. from NW cor. Sec. 28

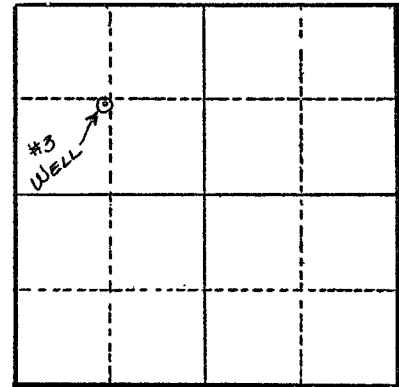

Section 28

Altitude at well

TYPE OF WELL: Drilled Date Constructed 1951

Depth drilled 40' Depth cased 40'

CASING RECORD:

12"

FINISH:

Torch cut perforations from 25 to 40 ft.

AQUIFERS:

WATER LEVEL:

16'

PUMPING EQUIPMENT: Type Cent. H.P. 40

Capacity 600 G.P.M.

WELL TESTS:

Drawdown 10 ft. after        hours 550 G.P.M.

Drawdown        ft. after        hours        G.P.M.

USE OF WATER Irrigation Temp.        °F. 19

SOURCE OF INFORMATION GR Record

DRILLER or DIGGER

ADDITIONAL DATA:

Log        Water Level Measurements        Chemical Analysis        Aquifer Test       

REMARKS:

Log: Sandy loam 0 to 12 ft.  
Sand 12 to 22 ft.  
Gravel 22 to 40 ft.

Irrigation of 32.5 acres.