

STATE ENGINEER
Salem, Oregon

MAR 5337

Well Record

STATE WELL NO. 6/3W-28E(1)
COUNTY Marion
APPLICATION NO. GR-1114

GR-1074

OWNER: Albert H. Pack


MAILING ADDRESS: Rt. 2, Box 49

LOCATION OF WELL: Owner's No. #1

CITY AND STATE: Salem, Oregon

SW 1/4 NW 1/4 Sec. 28 T. 6 S., R. 3 W., W.M.

Bearing and distance from section or subdivision corner 2000' S. & 700' E. from NW cor. Sec. 28.

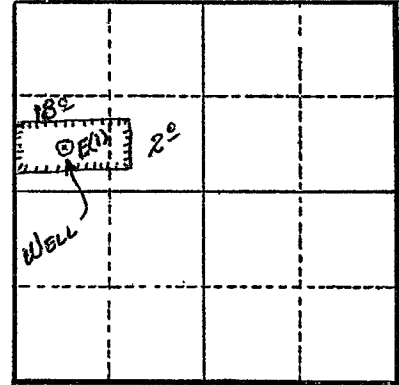

Section 28

Altitude at well 170 ft. ? 130'

TYPE OF WELL: Drilled Date Constructed 1953

Depth drilled 26 ft. Depth cased 26 ft.

CASING RECORD:

8 inch

FINISH:

AQUIFERS:

WATER LEVEL:

14 1/2 ft. (7 - 53)

PUMPING EQUIPMENT: Type Cent. 2x 3 in. H.P. 10

Capacity 300 G.P.M.

WELL TESTS:

Drawdown None ft. after hours 300 G.P.M.

Drawdown ft. after hours G.P.M.

USE OF WATER Irrigation Temp. °F., 19

SOURCE OF INFORMATION G. R. Record

DRILLER or DIGGER Roy Perkins

ADDITIONAL DATA:

Log Water Level Measurements Chemical Analysis Aquifer Test

REMARKS:

Log: Sandy loam 0 to 12 ft.
Gravel 12 to 26 ft.

Irrigation of 20 acres.