

STATE ENGINEER  
Salem, Oregon

5343  
MARI...

# Well Record

STATE WELL NO. 6/3W-28J(1)  
COUNTY Marion  
APPLICATION NO. GR-368

OWNER: Earl & Hazel Weathers


MAILING ADDRESS: Route 2, Box 77

LOCATION OF WELL: Owner's No. 2

CITY AND STATE: Salem, Oregon

NE 1/4 SE 1/4 Sec. 28 T. 6 N. S., R. 3 E. W., W.M.

Bearing and distance from section or subdivision corner 650 feet West and 2200 feet North from SE Corner, Section 28

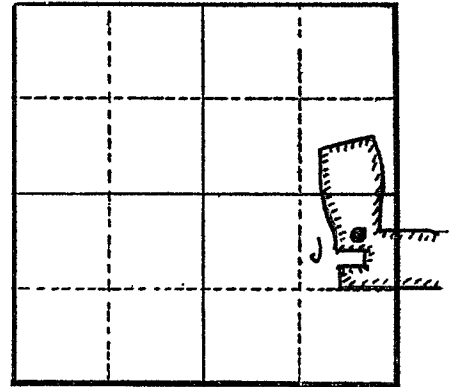

Section 28

Altitude at well 90 feet

TYPE OF WELL: Drilled Date Constructed 1944

Depth drilled 42 feet Depth cased 42 feet

### CASING RECORD:

10-inch

### FINISH:

### AQUIFERS:

### WATER LEVEL:

22 feet

PUMPING EQUIPMENT: Type Gardner-Denver Centrifugal H.P. 20

Capacity 500 G.P.M.

### WELL TESTS:

Drawdown ft. after hours G.P.M.

Drawdown ft. after hours G.P.M.

USE OF WATER Irrigation Temp. °F., 19

SOURCE OF INFORMATION GR-354

### DRILLER or DIGGER

### ADDITIONAL DATA:

Log  Water Level Measurements  Chemical Analysis  Aquifer Test

### REMARKS:

Moist dirt 0 to 22 feet  
Gravel 22 to 42 feet