

STATE ENGINEER
Salem, Oregon

5350
MARI.....

Well Record


STATE WELL NO. 6/3W-28M(1)
COUNTY Marion
APPLICATION NO. GR-489

OWNER: B. E. Stratton MAILING ADDRESS: Route 2, Box 55

LOCATION OF WELL: Owner's No. 2 CITY AND STATE: _____

N. E.
NW $\frac{1}{4}$ SW $\frac{1}{4}$ Sec. 28 T. 6 S., R. 3 W., W.M.

Bearing and distance from section or subdivision corner 2547.7 feet North and 436.9 feet East
from SW Corner, Section 28

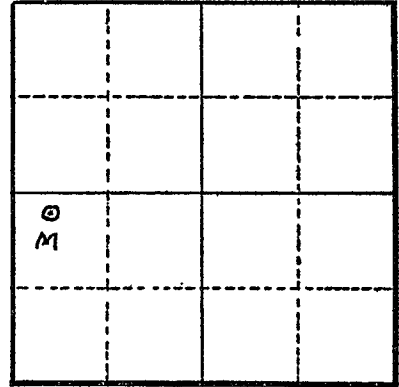

Section 28

Altitude at well 125 feet

TYPE OF WELL: Drilled Date Constructed April 10, 1945

Depth drilled 44 feet Depth cased _____

CASING RECORD:
8-inch

FINISH:

AQUIFERS:

WATER LEVEL:
27 feet (4-45)

PUMPING EQUIPMENT: Type Wass. Centrifugal H.P. 15
Capacity 350 G.P.M.

WELL TESTS:
Drawdown _____ ft. after _____ hours _____ G.P.M.
Drawdown _____ ft. after _____ hours _____ G.P.M.

USE OF WATER Irrigation 40.5 Temp. _____ °F. _____, 19____

SOURCE OF INFORMATION GR-470

DRILLER or DIGGER _____

ADDITIONAL DATA:

Log no Water Level Measurements _____ Chemical Analysis _____ Aquifer Test _____

REMARKS: