

STATE ENGINEER
Salem, Oregon

MARI.....

5353

Well Record

STATE WELL NO. 6/3W-28Q(1)
COUNTY Marion
APPLICATION NO. GR-655

OWNER: Orval E. Shryder

MAILING ADDRESS:

1955 Dallas Road


LOCATION OF WELL: Owner's No.

CITY AND STATE:

Salem, Oregon

SW 1/4 SE 1/4 Sec. 28 T. 6 N. S. R. 3 E. W., W.M.

Bearing and distance from section or subdivision corner
450 feet North and 1650 feet West
from SE Corner, Section 28

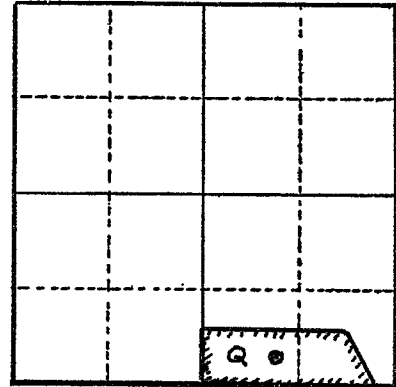

Section 28

Altitude at well 121 feet interpolated

TYPE OF WELL: Drilled Date Constructed 1940

Depth drilled 41 feet Depth cased 41 feet

CASING RECORD:

8-inch

FINISH:

AQUIFERS:

WATER LEVEL:

31 feet

PUMPING EQUIPMENT: Type to be replaced H.P.
Capacity G.P.M.

WELL TESTS:

Drawdown 20 ft. after 250 hours G.P.M.

Drawdown ft. after hours G.P.M.

USE OF WATER Irrigation 40 Temp. °F. 19

SOURCE OF INFORMATION GR-623
DRILLER or DIGGER

ADDITIONAL DATA:

Log Water Level Measurements Chemical Analysis Aquifer Test

REMARKS: