

STATE ENGINEER
Salem, Oregon

MARI... 5354

Well Record

STATE WELL NO. 6/3W-28R(1)
COUNTY Marion
APPLICATION NO. GR-368

OWNER: Earl & Hazel Weathers


MAILING ADDRESS: Route 2, Box 77

LOCATION OF WELL: Owner's No.

CITY AND STATE: Salem, Oregon

SE 1/4 SE 1/4 Sec. 28 T. 6 N. S. R. 3 W., W.M.

Bearing and distance from section or subdivision corner 750 feet West and 950 feet North from SW Corner, Section 28

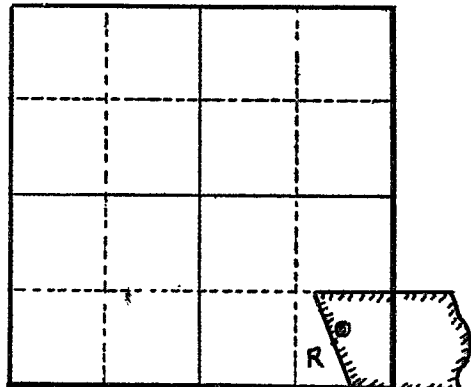

Section 28

Altitude at well 100 feet

TYPE OF WELL: Drilled Date Constructed 1945

Depth drilled 31 feet Depth cased 31 feet

CASING RECORD:

10 inch

FINISH:

Perforated 20 to 31

AQUIFERS:

WATER LEVEL:

8 feet 11.4 (1-13-60)

PUMPING EQUIPMENT: Type Cornell Centrifugal H.P. 20
Capacity 500 G.P.M.

WELL TESTS:

Drawdown ft. after hours G.P.M.
Drawdown ft. after hours G.P.M.

USE OF WATER Irrigation Temp. °F. 19

SOURCE OF INFORMATION GR-354

DRILLER or DIGGER

ADDITIONAL DATA:

Log Water Level Measurements Chemical Analysis Aquifer Test

REMARKS:

Moist dirt 0 to 13
Gravel 13 to 31