

STATE ENGINEER
Salem, Oregon

537
MARI.

Well Record

STATE WELL NO. 4/1W-15J
COUNTY Marion
APPLICATION NO. GR-1742


GR-1680

OWNER: Robert L. Dressler
MAILING ADDRESS: Rt. 1, Box 255

LOCATION OF WELL: Owner's No. CITY AND STATE: Aurora, Oregon

NE 1/4 SE 1/4 Sec. 15 T. 4 S., R. 1 W., W.M.

Bearing and distance from section or subdivision
corner 1050' W. & 2150' N. from SE cor. Sec. 15

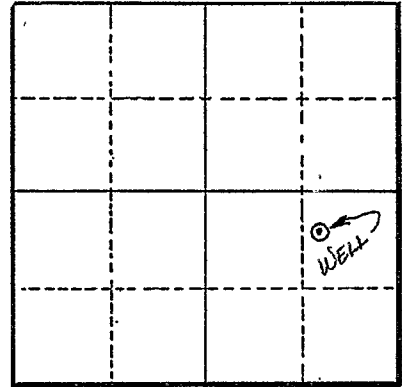

Section 15

Altitude at well 165

TYPE OF WELL: Drilled. Date Constructed 1952

Depth drilled 96' Depth cased 96'

CASING RECORD:

6"

FINISH:

AQUIFERS:

WATER LEVEL:

15' in Summer

PUMPING EQUIPMENT: Type Pomona turbine H.P. 5
Capacity 110 G.P.M.

WELL TESTS:

Drawdown 32 ft. after 110 hours G.P.M.
Drawdown ft. after hours G.P.M.

USE OF WATER Irrigation Temp. °F. 19

SOURCE OF INFORMATION GR Record

DRILLER or DIGGER J. T. Miller

ADDITIONAL DATA:

Log N.A. Water Level Measurements Chemical Analysis Aquifer Test

REMARKS:

Irrigation of 20 acres.