

STATE ENGINEER  
Salem, Oregon

MARI 5374

# Well Record

STATE WELL NO. 6/3W-33A  
COUNTY Marion  
APPLICATION NO. GR-1726

GR- 1675

OWNER: Earl & Hazel Weathers


MAILING ADDRESS: Rt. 2, Box 77

LOCATION OF WELL: Owner's No. #1

CITY AND STATE: Salem, Oregon

NE 1/4 NE 1/4 Sec. 33 T. 6 S., R. 3 W., W.M.

Bearing and distance from section or subdivision corner 1200' W. & 550' S. from NE cor. Sec. 33.

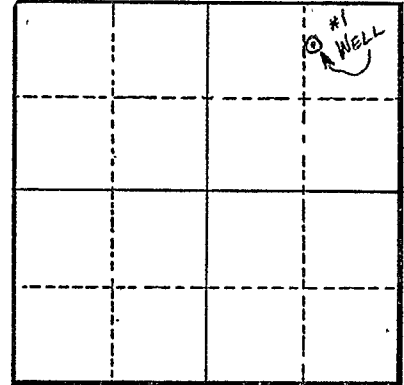

Section 33

Altitude at well 130'

TYPE OF WELL: Drilled Date Constructed 1953

Depth drilled 29' Depth cased 29'

### CASING RECORD:

8"

### FINISH:

Slot perforations: 1/2" x 6" (8/ft.) from 21 to 29 ft.

### AQUIFERS:

### WATER LEVEL:

17'

PUMPING EQUIPMENT: Type Cornell 4" Cent. H.P. 20

Capacity 500 G.P.M.

### WELL TESTS:

Drawdown 3 ft. after 500 hours G.P.M.

Drawdown ft. after hours G.P.M.

USE OF WATER Irrigation Temp. °F. 19

SOURCE OF INFORMATION GR Record

DRILLER or DIGGER Marion West

### ADDITIONAL DATA:

Log Water Level Measurements Chemical Analysis Aquifer Test

### REMARKS:

Log: Sandy dirt 0 to 14 ft.  
Gravel 14 to 29 ft.

Irrigation of 8.5 acres.