

STATE ENGINEER
Salem, Oregon

MAR 5377

Well Record

STATE WELL NO. 6/3W-33C(1)
COUNTY Marion
APPLICATION NO. GR-221

OWNER: Wm. Wiederkehr


MAILING ADDRESS: Route 1

LOCATION OF WELL: Owner's No.

CITY AND STATE: Jefferson, Oregon

NE 1/4 NW 1/4 Sec. 33 T. 6 N. S., R. 3 E. W., W.M.

Bearing and distance from section or subdivision corner South 37° 45' West 791 feet from NW Corner, Section 33

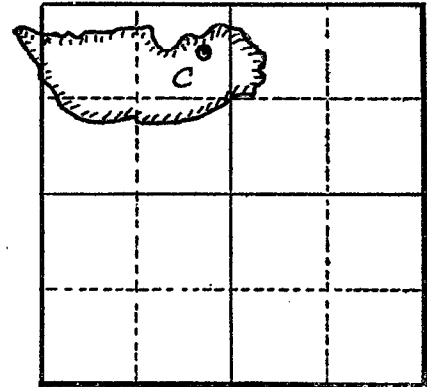

Section 33

Altitude at well 128 feet interpolated

TYPE OF WELL: Drilled Date Constructed 1947

Depth drilled 36 Depth cased 36

CASING RECORD:

10-inch casing set from 0 to 36 feet

FINISH:

perforated casing

AQUIFERS:

gravel - depth unknown

WATER LEVEL:

8 feet below land surface

PUMPING EQUIPMENT: Type Pacific Centrifugal H.P. 25
Capacity 400 G.P.M.

WELL TESTS: 5
Drawdown ft. after hours Pumping 400 G.P.M.
Drawdown ft. after hours G.P.M.

USE OF WATER Irrigation 100.8 Temp. °F., 19

SOURCE OF INFORMATION GR-205

DRILLER or DIGGER

ADDITIONAL DATA:

Log no Water Level Measurements Chemical Analysis Aquifer Test

REMARKS: