

STATE ENGINEER
Salem, Oregon

MAR. 5378 Well Record
GR- 1676

STATE WELL NO. 6/3W-33H
COUNTY Marion
APPLICATION NO. GR-1727

OWNER: Earl & Hazel Weathers


MAILING ADDRESS: Rt. 2, Box 77

LOCATION OF WELL: Owner's No. #2

CITY AND STATE: Salem, Oregon

SE 1/4 NE 1/4 Sec. 33 T. 6 N. S. R. 3 W., W.M.

Bearing and distance from section or subdivision
corner 400' W. & 1600' S. from NE cor. Sec. 33.

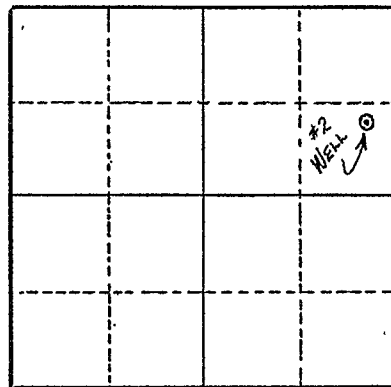

Section 33

Altitude at well 130'

TYPE OF WELL: Drilled Date Constructed 1953

Depth drilled 41' Depth cased 41'

CASING RECORD:

8"

FINISH:

Perforated: 1/4" x 2" (15/ft.) from 23 to 40 ft.

AQUIFERS:

WATER LEVEL:

18' (6 - - 53)

PUMPING EQUIPMENT: Type Cornell 4" Cent. H.P. 20

Capacity 500 G.P.M.

WELL TESTS:

Drawdown 8 ft. after 600 hours G.P.M.

Drawdown ft. after hours G.P.M.

USE OF WATER Irrigation Temp. °F. 19

SOURCE OF INFORMATION GR Record

DRILLER or DIGGER

ADDITIONAL DATA:

Log Water Level Measurements Chemical Analysis Aquifer Test

REMARKS:

Log: Top soil 0 to 2 ft.
Silt 2 to 14 ft.
Clay 14 to 19 ft.
Cemented gravel 19 to 23 ft.
Water gravel #4 23 to 27 ft.
Cement gravel W-B 27 to 37 ft.
Water gravel #2 37 to 41 ft.

Irrigation of 27 acres.