

STATE ENGINEER  
Salem, Oregon

MARI 5379 Well Record

STATE WELL NO. 6/3W-33K(1)  
COUNTY Marion  
APPLICATION NO. GR-91

OWNER: T. B. Jorgensen


MAILING ADDRESS:

LOCATION OF WELL: Owner's No.

CITY AND STATE: Salem, Oregon

NW 1/4 SE 1/4 Sec. 33 T. 6 S. R. 3 W., W.M.

Bearing and distance from section or subdivision  
corner 23 chains North and 22 chains West from SE  
Corner, Section 33

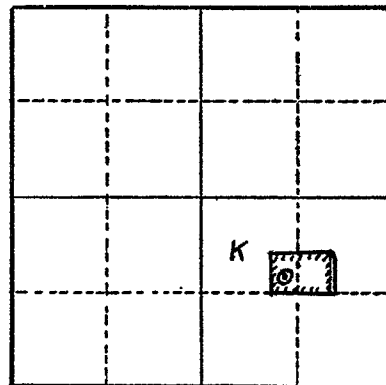

Section 33

Altitude at well 96 feet interpolated

TYPE OF WELL: Drilled Date Constructed 5-26-46

Depth drilled 22 feet Depth cased 22 feet

CASING RECORD:

8-inch casing set from 0 to 22 feet open end

FINISH:

6 perforations to the foot

AQUIFERS:

sand and gravel from 12 to 22 feet

WATER LEVEL:

4 to 10 feet below land surface May 1946

PUMPING EQUIPMENT: Type Fairbanks-Morse Centrifugal H.P. 5  
Capacity 175 G.P.M.

WELL TESTS:

Drawdown 22 ft. after hours Pumping 375 G.P.M.  
Drawdown ft. after hours G.P.M.

USE OF WATER Irrigation 13 Temp. °F. 19

SOURCE OF INFORMATION GR-87

DRILLER or DIGGER

ADDITIONAL DATA:

Log X Water Level Measurements Chemical Analysis Aquifer Test

REMARKS:

soil 0 to 12 feet 12  
sand 12 to 18 feet 6  
gravel 18 to 22 feet 4