

STATE ENGINEER
Salem, Oregon

MARI... 538

Well Record

STATE WELL NO. 4/1W-15P(1)
COUNTY Marion
APPLICATION NO. GR-180

OWNER: Henry Lettenmaier

MAILING ADDRESS:

Route 1, Box 250


LOCATION OF WELL: Owner's No. #1

CITY AND STATE:

Aurora, Oregon

SE 1/4 SW 1/4 Sec. 15 T. 4 N. S. R. 1 E. W., W.M.

Bearing and distance from section or subdivision corner 120 rods E. and 330' North from SW cor. of Sec. 15

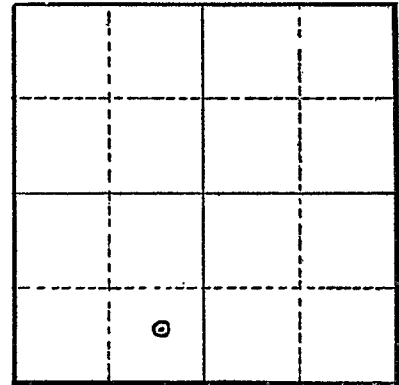

Section 15

Altitude at well 178 feet Interpolated

TYPE OF WELL: Drilled Date Constructed Oct. '51

Depth drilled 110' Depth cased 110'

CASING RECORD:

12 inch steel casing set from 0 to 110 feet

FINISH:

Perforations, 3/4 inch set between 98 and 105 feet

AQUIFERS:

Unknown

WATER LEVEL:

32 feet below land surface 12/15/51

PUMPING EQUIPMENT: Type Turbine H.P. 20
Capacity 400 G.P.M.

WELL TESTS:

Drawdown 51 ft. after hours pumping 320 G.P.M.
Drawdown 57 ft. after hours pumping 360 G.P.M.

USE OF WATER Irrigation 77 acres Temp. °F., 19

SOURCE OF INFORMATION Registration Statement GR-180

DRILLER or DIGGER J. T. Miller

ADDITIONAL DATA:

Log No Water Level Measurements Chemical Analysis Aquifer Test

REMARKS: