
WATER WELL REPORT STATE OF OREGON

ECEIVED MARI 5384 MAY 0 4 1981

WATER RESOURCES DEPT SALEM, OREGON

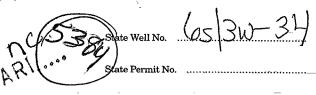

(1) OWNER:	(10) LOCATION OF WELL:
Name Keizer Water District	County Marion Driller's well number 8106
Address 641 Chemawa Rd NE	Deliver of Work Medical Control of the Control of t
City Salem State Oregon	NE 4 SE 4 Section 34 T. 6S R. 3W W.M. Tax Lot # Lot Blk Subdivision
	Address at well location: NW corner of McNary High
(2) TYPE OF WORK (check):	School Property (McNary Site)
New Well	
If abandonment, describe material and procedure in Item 12.	(11) WATER LEVEL: Completed well. Depth at which water was first found 16
(3) TYPE OF WELL: (4) PROPOSED USE (check):	Departed wilder was kind to dark
Rotary Air X Driven Domestic Industrial Municipal X	Static level 14.5" ft. below land surface. Date 4/15/83
Rotary Mud Dug Irrigation Test Well Other	Artesian pressure lbs. per square inch. Date
X Bored Thermal: Withdrawal Reinjection	(12) WELL LOG: Diameter of well below casing
(5) CASING INSTALLED: Steel X Plastic	Depth drilled 232 ft. Depth of completed well 205 ft.
Threaded □ Welded 📆	Formation: Describe color, texture, grain size and structure of materials; and show thickness and nature of each stratum and aquifer penetrated, with at least one entry
16 IPbiam from +3 6" ft. to 119 ft5"Gauge .312	for each change of formation. Report each change in position of Static Water Level
16 IDbiam from 200 ft. to 205 ft. Gauge 312	and indicate principal water-bearing strata.
MINER INSTALLEDXX	MATERIAL From To SWL
30"Diam.from+2.9" ft. to96 ft. Gauge400	* Well was drilled to 186' with
(A) DEDEOD ACTONG	reverse circulation rotary. Because
(6) PERFORATIONS: Perforated? ☐ Yes ▼ No Type of perforator used	of large rocks, hole deviated ex-
	cessively between 150 and 186' re-
Size of perforations in. by in.	sulting in the loss of some drill
perforations from ft. to ft.	stem and bit. The hole was then
perforations from	backfilled from 186' to amprox-
perforations from ft. to ft.	imately 145' and a cable tool rig
(7) SCREENS: Well screen installed? X Yes \(\subseteq \text{No} \)	drilled a 20" hole from 145' to
Manufacturer's Name UOP Johnson	232.
Type Double Extra Strong Model No. HI-CAP	3/
Diam. 16"P.S. Slot Size . 150 Set from 119.5"t. to 200 ft.	
Diam. Slot Size Set from ft. to ft.	See sheet Attached
Drawdown is amount water level is lawared	for well log
(8) WELL TESTS: below static level	TOT METT TOR
Was a pump test made? X Yes No If yes, by whom? SET	
t: 1500 gal./min. with 39 ft. drawdown after 36 hrs.	
" " "	
Air test gal./min. with drill stem at ft. hrs.	
Bailer test gal/min. with ft. drawdown after hrs.	
Artesian flow g.p.m.	
erature of water Depth artesian flow encountered ft.	1/16 97 1/16 07
(a) (a) (a)	Work started 1/15 19 81 Completed 4/16 19 81
(9) CONSTRUCTION: Special standards: Yes □ No 🛣	Date well drilling machine moved off of well 4/16 19 81
Well seal—Material used neat cement	Drilling Machine Operator's Certification:
Well sealed from land surface to	This well was constructed under my direct supervision. Materials used
Diameter of well bore to bottom of seal 36+ in.	and information reported above are true to my best knowledge and belief.
Diameter of well bore below seal30+in. to 145° 29"2 to Number of sacks of cement used in well seal	[Signed] January Date 4/30,19 81
	Drilling Machine Operator's License No. 1085
How was cement grout placed? Pumped between 30" casir	8
and borehole wall from 96' up.	Water Well Contractor's Certification:
Mo.	This well was drilled under my jurisdiction and this report is true to the best of my knowledge and belief.
Was pump installed?	Name Schneider Equipment, Inc.
Was a drive shoe used? ► Yes □ No Plugs Size: location ft.	(Type or print)
Did any strata contain unusable water? ☐ Yes ☒ No	Address 21981 Piver/Rd WE. St. Paul. Or
Type of Water? depth of strata	155: Al Marin) L Se hange da
Method of sealing strata off	[Signed]
Was well gravel packed? ☐ Yes ☐ No Size of gravel:	Contractor's License No. 649 Date 4-30 19 81
Gravel placed from top ft. to bottom ft.	, 10
MODICE TO WATER WELL COMPRACTOR	WARRED DEGOVERAGE DEDARGE TO THE

Keizer Water District
Mc Nary Site

#8106

Material	From	То
top soil, brown, sandy	0	5
Clay, brown, sandy, w/ some gravel	5	10
Sand & gravel, brown	10	15
Gravel & sand, coarse up to 8", loose	15	68
Clay, blue-gray w/ some gravel	68	71
Large Gravel & sand, black w/ traces of clay,	71	76
Large gravel & sand, med-coarse, black	76	91
Clay, gray	91	98
 Gravel & sand, medium, loosely cemented	98	113
Gravel up to 4" + sand, black, med-fine loosely cemented	113	115
Clay, brownish gray, fine sandy	115	118
Gravel & sand, cemented up to 4"	118	128
Gravel up to 8" & sand, med-coarse, black, loosely cemented	128	138
Gravel up to 10" w/ some sand, loose	138	153
Gravel up to 8" w/ sand, coarse, brown, some cemented	153	173
Gravel up to 8" w/ sand, fine-medium	173	185
Large gravel, w/ sand, med-fine	185	191
Large gravel, w sand, w/ clay, brown, red & gray	191	200
Large gravel, w/ clay, brown	200	232
· •	1	

RECEIVED

MAY 0 4 1981

WATER RESOURCES DEPT SALEM. OREGON

MARI 5384

OREGON HEALTH DIV SION ONLY:

Received Date:

County Well Log ID #

9/18/00

MARI 5384

WELL IDENTIFICATION LABEL ATTACHMENT FORM (OREGON HEALTH DIVISION)

COMPANY/CURRENT WELL OWNER	OWNER (S) WELL NO: #9
Name: City of Keizer	
Mailing Address: P.O. Box 21000	
City: Ke.zer State: O	2 Zin: 97307 Phone: (603) 390-3700
CONTACT PERSON:	
NAME: Jee Edgell	THONE # (503) 390-3700
THIS FORM IS ONLY	TO BE USED FOR WELLS WITH
POSITIV	ELY IDENTIFIED
WATER SLIP	PLY WELL REPORTS.
WITTER SCI	I E I WELL REI ORIS.
	OFFICIAL USE ONLY
О.Н.Д.	
O.H.D. TOWNSHIP:6N / S RANGE: Well Identification Label: L32106	OFFICIAL USE ONLY 33/W SECTION: 34TAX-LOT: 3200
O.H.D. TOWNSHIP:GN / S RANGE:	OFFICIAL USE ONLY 33/W SECTION: 34TAX-LOT: 3200
O.H.D. TOWNSHIP:6N/\s RANGE: Well Identification Label: L-32106 LABEL ATTACHED BY:Tom Patt (O.H.D. OFFICIAL)	OFFICIAL USE ONLY 33/W SECTION: 34TAX-LOT: 3200
O.H.D. TOWNSHIP:	official use only SECTION: 34 TAX-LOT: 3200 DATE: 8/18/00