

STATE ENGINEER  
Salem, Oregon

MAR 5 404

# Well Record

GR- 1457

STATE WELL NO. 6/3W-34A  
COUNTY Marion  
APPLICATION NO. GR- 1509

OWNER: J. D. Schackman


MAILING ADDRESS: 6605 Wheatland Rd.

LOCATION OF WELL: Owner's No.

CITY AND STATE: Salem, Oregon

NE 1/4 NE 1/4 Sec. 34 T. 6 S., R. 3 W., W.M.

Bearing and distance from section or subdivision  
corner 1000' W. & 100' S. from NE cor. Sec. 34

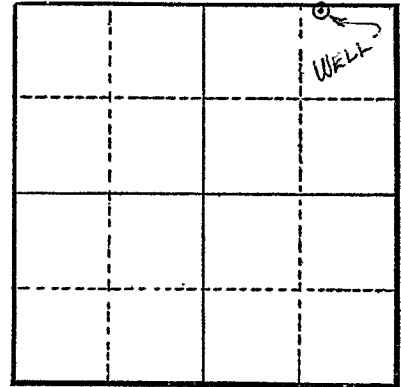

Section 34

Altitude at well 118

TYPE OF WELL: Drilled Date Constructed 1954

Depth drilled 107' Depth cased 107'

CASING RECORD:  
12"

FINISH:  
Perforated

AQUIFERS:

WATER LEVEL:  
18' (4- -54)

PUMPING EQUIPMENT: Type Cent. H.P. 25  
Capacity 200 G.P.M.

WELL TESTS:  
Drawdown ft. after hours G.P.M.  
Drawdown ft. after hours G.P.M.

USE OF WATER Irrigation Temp. °F. 19

SOURCE OF INFORMATION GR Record

DRILLER or DIGGER Harris Evans

ADDITIONAL DATA:

Log N.A. Water Level Measurements Chemical Analysis Aquifer Test

REMARKS:  
Irrigation of 40 acres.