

STATE ENGINEER
Salem, Oregon

MARI. 5408

Well Record

GR- 1508


STATE WELL NO. 6/3W-34D(1)
COUNTY Marion
APPLICATION NO. GR- 1566

OWNER: Wayne L. Weeks (Weeks Berry Nursery) MAILING ADDRESS: 3495 N. River Road

LOCATION OF WELL: Owner's No. #2 CITY AND STATE: Salem, Oregon

NW 1/4 NW 1/4 Sec. 34 T. 6 S., R. 3 W., W.M.

Bearing and distance from section or subdivision corner 350' E. & 25' S. of NW cor. Sec. 34

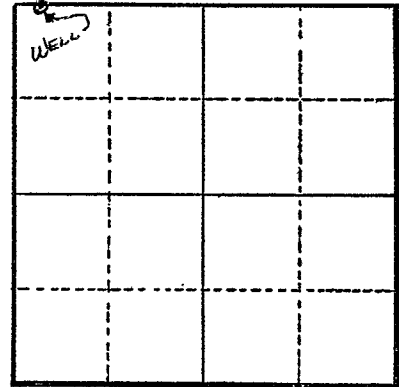

Altitude at well 140' ? 125'

TYPE OF WELL: Drilled Date Constructed 1949

Depth drilled 38' Depth cased 38'

Section 34

CASING RECORD:
8"

FINISH:
Perforated with 6" x 5/16" torch cuts from 22 to 37 ft.

AQUIFERS:

WATER LEVEL:
13' on 4/19/49 22' on 9/1/57

PUMPING EQUIPMENT: Type Berkeley 2 1/2" Cent. H.P. 20
Capacity 350 G.P.M.

WELL TESTS:
Drawdown 9 ft. after 300 hours G.P.M.
Drawdown ft. after hours G.P.M.

USE OF WATER Irrigation Temp. °F. 19

SOURCE OF INFORMATION GR Record
DRILLER or DIGGER J. A. Sneed & Sons

ADDITIONAL DATA:
Log Water Level Measurements Chemical Analysis Aquifer Test

REMARKS:

- Log: Top soil 0 to 2 ft.
- Sandy soil & gravel 2 to 12 ft.
- Brown sand 12 to 15 ft.
- Cemented gravel #4" 15 to 22 ft.
- Water sand & gravel #2" 22 to 38 ft.

Irrigation of 34 acres.