

STATE ENGINEER
Salem, Oregon

MARK 54/12

Well Record

STATE WELL NO. 6/3W-34E(1)
COUNTY Marion
APPLICATION NO. GR-1728

GR- 1677

OWNER: Earl & Hazel Weathers


MAILING ADDRESS: Box 77, Rt. 2

LOCATION OF WELL: Owner's No. #3

CITY AND STATE: Salem, Oregon

SW $\frac{1}{4}$ NW $\frac{1}{4}$ Sec. 34 T. 6 N S., R. 3 E W., W.M.

Bearing and distance from section or subdivision corner 750' E. & 2300' S. from NW cor. Sec. 34

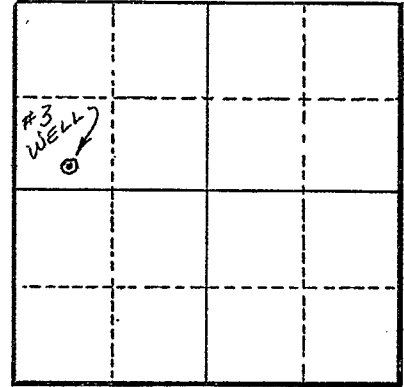

Section 34

Altitude at well 130'

TYPE OF WELL: Drilled Date Constructed 1955

Depth drilled 40' Depth cased 40'

CASING RECORD:

8" ? 10"

FINISH:

Perforated: $\frac{1}{2}$ " x 2" (25/ft.) from 23 to 38 ft.

AQUIFERS:

WATER LEVEL:

16' Jan, 1955

PUMPING EQUIPMENT: Type Cornell 4" Cent. H.P. 20

Capacity 500 G.P.M.

WELL TESTS:

Drawdown 4 ft. after 600 hours G.P.M.

Drawdown _____ ft. after _____ hours G.P.M.

USE OF WATER Irrigation Temp. _____ °F., 19

SOURCE OF INFORMATION GR Record

DRILLER or DIGGER _____

ADDITIONAL DATA:

Log _____ Water Level Measurements _____ Chemical Analysis _____ Aquifer Test _____

REMARKS:

Log: Top soil	0 to 3 ft.
Silt	3 to 16 ft.
Cemented gravel #4	16 to 20 ft.
Water gravel #4	20 to 27 ft.
Cement gravel	27 to 37 ft.
Water gravel #2	37 to 40 ft.

Irrigation of 25 acres.