

STATE ENGINEER
Salem, Oregon

Well Record
MARION 5414

STATE WELL NO. 6/3W-34E(1)
COUNTY Marion
APPLICATION NO. GR-1307

GR- 1264

OWNER: Lawrence A. Schmitz


MAILING ADDRESS: 1340 McDonald St.

LOCATION OF WELL: Owner's No.

CITY AND STATE: Salem, Oregon

SE 1/4 NW 1/4 Sec. 34 T. 6 S., R. 3 W., W.M.

Bearing and distance from section or subdivision
corner 2450' E. & 2150' S. from NW cor. Sec. 34.

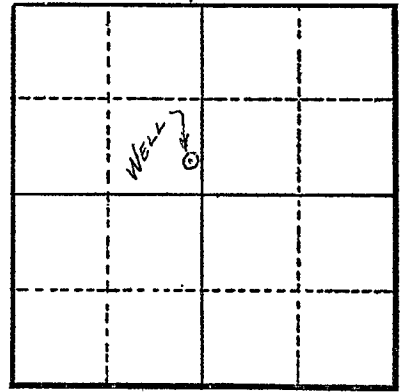

Altitude at well 130'

Section 34

TYPE OF WELL: Drilled Date Constructed 1951

Depth drilled 40 ft. Depth cased 40 ft.

CASING RECORD:

10 inch

FINISH:

AQUIFERS:

WATER LEVEL:

15 ft.

PUMPING EQUIPMENT: Type Westinghouse Cent. H.P. 15

Capacity G.P.M.

WELL TESTS:

Drawdown ft. after hours G.P.M.
Drawdown ft. after hours G.P.M.

USE OF WATER Irrigation Temp. °F. 19

SOURCE OF INFORMATION G. R. Record

DRILLER or DIGGER

ADDITIONAL DATA:

Log Water Level Measurements Chemical Analysis Aquifer Test

REMARKS:

Log: Top soil 0 to 10 ft.
Gravel 10 to 40 ft.

Irrigation of 10 acres.