

STATE ENGINEER  
Salem, Oregon

MAR 5416  
JUANITA MANUEL

# OBSERVATION WELL Well Record


STATE WELL NO. 6/3W-34G(1)  
COUNTY Marion  
APPLICATION NO. GR-548

OWNER: Paul Pierce  
MAILING ADDRESS: 5615 N. River Road

LOCATION OF WELL: Owner's No. \_\_\_\_\_  
CITY AND STATE: Salem, Oregon

SW 1/4 1/4 NE 1/4 1/4 Sec. 34 T. 6 N. S. R. 3 E. W., W.M.

Bearing and distance from section or subdivision  
corner 1/2 mile North and 1600 feet West of  
SE Corner, Section 34

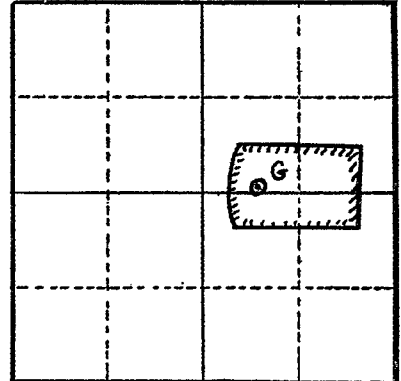

Section 34

Altitude at well 150 feet

TYPE OF WELL: Drilled Date Constructed prior to 1940

Depth drilled 33 feet Depth cased 33 feet

### CASING RECORD:

12-inch

### FINISH:

### AQUIFERS:

### WATER LEVEL:

12 feet 13.19 (6-6-60)

PUMPING EQUIPMENT: Type Fairbanks Morse 2" H.P. 20  
Capacity 140 G.P.M.

### WELL TESTS:

Drawdown 18 ft. after 125 hours G.P.M.  
Drawdown \_\_\_\_\_ ft. after \_\_\_\_\_ hours G.P.M.

USE OF WATER Irrigation 48 Temp. \_\_\_\_\_ °F., 19

SOURCE OF INFORMATION GR-523

DRILLER or DIGGER \_\_\_\_\_

### ADDITIONAL DATA:

Log \_\_\_\_\_ Water Level Measurements \_\_\_\_\_ Chemical Analysis \_\_\_\_\_ Aquifer Test \_\_\_\_\_

### REMARKS:

top soil 0 to 12 feet  
water gravel 12 to 23 feet

### Water Level Record

OWNER: Paul Pierce OWNER'S NO. \_\_\_\_\_

Description of measuring point: Top of casing which is 8 feet below LSD.

Date	Water Level Feet (above) (below) Land Surface	Remarks	Date	Water Level Feet (above) (below) Land Surface	Remarks
<u>7/19/57</u>	<u>17.44</u>	<u>JES. not used (1957)</u>			
<u>6-11-58</u>	<u>14.65</u>	<u>WSB</u>			
<u>8-18-58</u>	<u>17.<sup>53</sup><del>17.73</del></u>	<u>JES</u>			
<u>5-6-59</u>	<u>13.37</u>	<u>WSB</u>			
<u>11-30-59</u>	<u>17.40</u>	<u>WSB</u>			
<u>6-6-60</u>	<u>13.19</u>	<u>WSB</u>			
<u>11-7-60</u>	<u>17.94</u>	<u>WSB</u>			
<u>3-30-61</u>		<u>WSB (water over top of casing)</u>			
<u>11-2-61</u>	<u>18.05</u>	<u>WSB &amp; RD</u>			

REMARKS: \_\_\_\_\_  
 \_\_\_\_\_  
 \_\_\_\_\_  
 \_\_\_\_\_