

STATE ENGINEER
Salem, Oregon

5420
MARI... Well Record

STATE WELL NO. 6/3W-34M(1)
COUNTY Marion
APPLICATION NO. GR-81

OWNER: Roy J. Hoffman


MAILING ADDRESS: Route 2, Box 168

LOCATION OF WELL: Owner's No.

CITY AND STATE: Salem, Oregon

NE 1/4 SW 1/4 Sec. 34 T. 6 N. S., R. 3 E. W., W.M.

Bearing and distance from section or subdivision corner 550 feet West from NE 1/4 Corner, NW 1/4 SW 1/4, Section 34

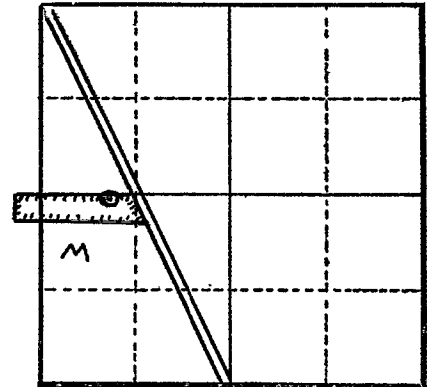

Section 34

Altitude at well

TYPE OF WELL: Drilled Date Constructed 7-15-54

Depth drilled 63 feet Depth cased 63 feet

CASING RECORD:

10-inch casing set from 0 to 63 feet

FINISH:

unk

AQUIFERS:

unk

WATER LEVEL:

15 feet below land surface - July 1954

PUMPING EQUIPMENT: Type Fairbanks-Morse Deepwell H.P. 15

Capacity 500 G.P.M.

WELL TESTS:

Drawdown ft. after hours G.P.M.

Drawdown ft. after hours G.P.M.

USE OF WATER Irrigation 20 Temp. °F. 19

SOURCE OF INFORMATION GR-69

DRILLER or DIGGER

ADDITIONAL DATA:

Log no. Water Level Measurements Chemical Analysis Aquifer Test

REMARKS: