

STATE ENGINEER
Salem, Oregon

5423

Well Record

STATE WELL NO. 6/3W - 34R
COUNTY MARION
APPLICATION NO. GR-2273

OWNER: Roy M. Magster

MAILING ADDRESS:

605 E. Chemawa Road N.


LOCATION OF WELL: Owner's No.

CITY AND STATE:

Salem, Oregon

SE 1/4 SE 1/4 Sec. 34 T. 6 N. S. R. 3 E. W., W.M.

Bearing and distance from section or subdivision corner 740' W. and 700' N.

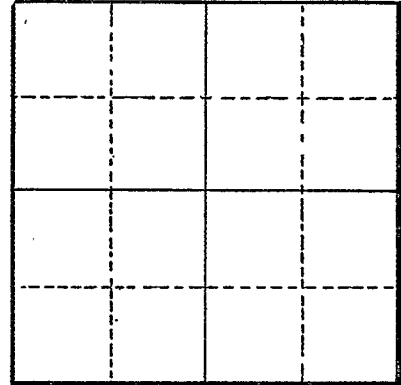

Section

Altitude at well

TYPE OF WELL: Drilled Date Constructed 1949

Depth drilled 50 Depth cased 50

CASING RECORD:

6-Inch

FINISH:

AQUIFERS:

WATER LEVEL:

PUMPING EQUIPMENT: Type Berkley H.P. 7 1/2
Capacity 250 G.P.M.

WELL TESTS:

Drawdown ft. after hours G.P.M.
Drawdown ft. after hours G.P.M.

USE OF WATER Irrigation Temp. °F., 19

SOURCE OF INFORMATION GR-2166

DRILLER or DIGGER

ADDITIONAL DATA:

Log Water Level Measurements Chemical Analysis Aquifer Test

REMARKS: