

STATE ENGINEER
Salem, Oregon

MAR 5425

Well Record

STATE WELL NO. 6/3-34R
COUNTY Marion
APPLICATION NO. GR-3374

OWNER: Onas S. Olson


MAILING ADDRESS: 665 Chemawa Road

LOCATION OF WELL: Owner's No.

CITY AND STATE: Salem, Oregon

SE 1/4 SE 1/4 Sec. 34 T. 6 S., R. 3 W., W.M.

Bearing and distance from section or subdivision
corner 327' N. & 487' W. from SE corner Sec. 34

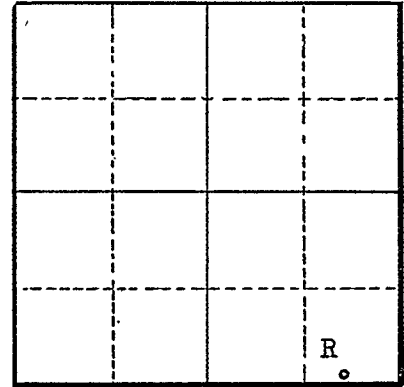

Section 34

Altitude at well

TYPE OF WELL: Drilled Date Constructed 3/53

Depth drilled 57' Depth cased 57'

CASING RECORD:

8-inch

FINISH:

5 perforations per foot

AQUIFERS:

Sandy clay loam, Gravel

WATER LEVEL:

22'

PUMPING EQUIPMENT: Type Berkeley Turbine H.P. 5

Capacity 180 G.P.M.

WELL TESTS:

Drawdown 10 ft. after 600 hours G.P.M.

Drawdown ft. after hours G.P.M.

USE OF WATER Irrigation Temp. °F., 19

SOURCE OF INFORMATION GR-4001

DRILLER or DIGGER Harry Robinson, 2214 N. Front St., Salem, Oregon

ADDITIONAL DATA:

Log Water Level Measurements Chemical Analysis Aquifer Test

REMARKS:

Sandy Clay Loam 0 to 22
Gravel 22 to 57