

STATE ENGINEER  
Salem, Oregon

MAR 54 57 Well Record  
GR- 1656

STATE WELL NO. 6/3W-35J(1)  
COUNTY Marion  
APPLICATION NO. GR- 1707

OWNER: Archie Claggett


MAILING ADDRESS: 2175 Chemawa Rd.

LOCATION OF WELL: Owner's No.

CITY AND STATE: Salem, Oregon

NE 1/4 SE 1/4 Sec. 35 T. 6 S., R. 3 W., W.M.

Bearing and distance from section or subdivision corner 3400' S. & 350' W. from NE cor. Sec. 35

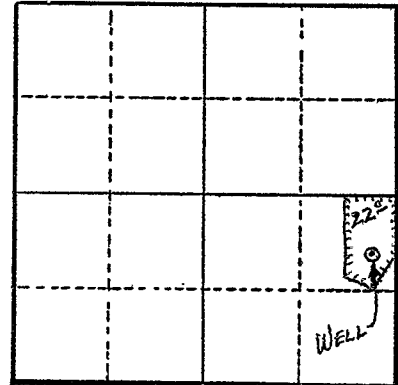

Section 35

Altitude at well 145'

TYPE OF WELL: Drilled Date Constructed 1951

Depth drilled 59' Depth cased 59'

CASING RECORD:

10"

FINISH:

Perforated with 5/16" x 6" slots (6) from 48 to 58 ft.

AQUIFERS:

WATER LEVEL:

12'

PUMPING EQUIPMENT: Type Cent. H.P. 5  
Capacity 136 G.P.M.

WELL TESTS:

Drawdown 6 ft. after 150 hours G.P.M.

Drawdown ft. after hours G.P.M.

USE OF WATER Irrigation Temp. °F. 19

SOURCE OF INFORMATION GR Record

DRILLER or DIGGER

ADDITIONAL DATA:

Log Water Level Measurements Chemical Analysis Aquifer Test

REMARKS:

Log: Top soil & silt 0 to 12 ft.  
Sand & gravel 12 to 59 ft.

Irrigation of 22 acres.