

STATE ENGINEER
Salem, Oregon

MAR 1958 **Well Record**


STATE WELL NO. 6/3W-35K
COUNTY Marion
APPLICATION NO. GR-2090

OWNER: Orlin L. Iverson
MAILING ADDRESS: 1390 Harmony Drive

LOCATION OF WELL: Owner's No. _____
CITY AND STATE: Salem, Oregon

NW 1/4 SE 1/4 Sec. 35 T. 6 N. S, R. 3 E. W, W.M.

Bearing and distance from section or subdivision
corner North 77° 31' East 1412 feet to
1/4 Corner

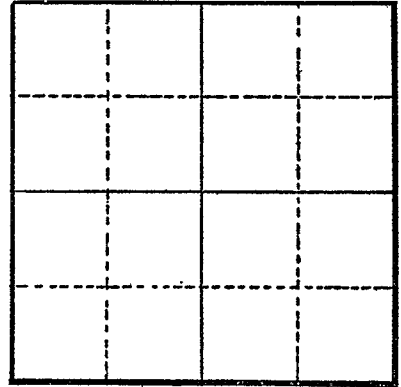

Section

Altitude at well 135 feet

TYPE OF WELL: Drilled Date Constructed 1947

Depth drilled 65 feet Depth cased 65 feet

CASING RECORD:

10-inch

FINISH:

AQUIFERS:

WATER LEVEL:

4 feet

PUMPING EQUIPMENT: Type Rainflow H.P. 30

Capacity 600 G.P.M.

WELL TESTS:

Drawdown 2 ft. after _____ hours Pumping 600 G.P.M.

Drawdown 5 ft. after _____ hours Pumping 400 G.P.M.

USE OF WATER Irrigation 25 Temp. _____ °F., 19

SOURCE OF INFORMATION GR-2008

DRILLER or DIGGER

ADDITIONAL DATA:

Log _____ Water Level Measurements _____ Chemical Analysis _____ Aquifer Test _____

REMARKS: