

STATE ENGINEER
Salem, Oregon

MAR 5462 Well Record


STATE WELL NO. 6/3W-35P
COUNTY MARION
APPLICATION NO. GR-2887

OWNER: John R. Buchanan Lucy R. Buchanan MAILING ADDRESS: Rt. 2, Box 158

LOCATION OF WELL: Owner's No. CITY AND STATE: Monmouth, Oregon

SE 1/4 SW 1/4 Sec. 35 T. 6 N. S., R. 3 E. W., W.M.

Bearing and distance from section or subdivision corner N. 703' & W. 785'

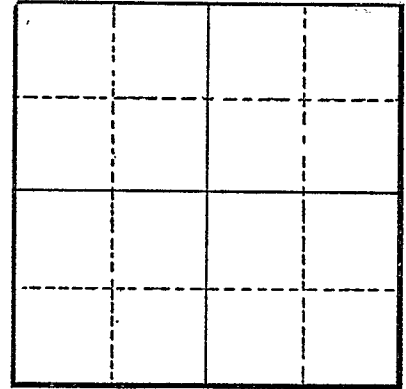

Section

Altitude at well

TYPE OF WELL: drilled Date Constructed 1953

Depth drilled 52 Depth cased 52

CASING RECORD:

6-inch

FINISH:

AQUIFERS:

WATER LEVEL:
14-feet

PUMPING EQUIPMENT: Type Jacuzzi Jet H.P. 3
Capacity 22 1/2 G.P.M.

WELL TESTS:

Drawdown ft. after hours G.P.M.
Drawdown ft. after hours G.P.M.

USE OF WATER irrigation Temp. °F. 19

SOURCE OF INFORMATION GR-2716

DRILLER or DIGGER

ADDITIONAL DATA:

Log Water Level Measurements Chemical Analysis Aquifer Test

REMARKS: