

MAR 15 5:16 PM '50


Well Record

OWNER: T. Jack Kundert
MAILING ADDRESS: 1210 Claggett Street

LOCATION OF WELL: Owner's No. _____
CITY AND STATE: Salem, Oregon

SE 1/4 SW 1/4 Sec. 35 T. 6 N. S., R. 3 E. W., W.M.

Bearing and distance from section or subdivision corner 304.6' W. and 311.2' N.

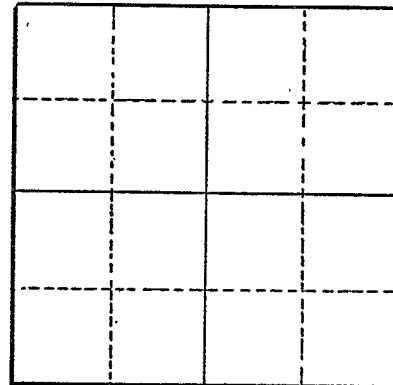

Section _____

Altitude at well 130'

TYPE OF WELL: Drilled Date Constructed 1950

Depth drilled 32 Depth cased 32

CASING RECORD:

6-inch

FINISH:

AQUIFERS:

Gravel

WATER LEVEL:

14-feet May, 1950

PUMPING EQUIPMENT: Type Jacuzzi Jet H.P. 1
Capacity 25 G.P.M.

WELL TESTS:

Drawdown 6 ft. after _____ hours Pumping 40 G.P.M.
Drawdown _____ ft. after _____ hours _____ G.P.M.

USE OF WATER Irrigation Temp. °F. _____, 19

SOURCE OF INFORMATION GR-2173

DRILLER or DIGGER _____

ADDITIONAL DATA:

Log Water Level Measurements _____ Chemical Analysis _____ Aquifer Test _____

REMARKS:

Topsoil 3 3
Yellow clay 10 13
Sand 3 16
Cemented gravel 15 31
Water gravel 1 32