

STATE ENGINEER  
Salem, Oregon

MAT: 5465

# Well Record

GR- 1787

STATE WELL NO. 6/3W-35R  
COUNTY Marion  
APPLICATION NO. GR- 1842

OWNER: Arthur E. Aldenburg ? Goldenburg


MAILING ADDRESS: 1885 E. Chemawa Rd.

LOCATION OF WELL: Owner's No.

CITY AND STATE: Salem, Oregon

SE 1/4 SE 1/4 Sec. 35 T. 6 S., R. 3 W., W.M.

Bearing and distance from section or subdivision corner 1150' W. & 1180' N. from SE cor. Sec. 35

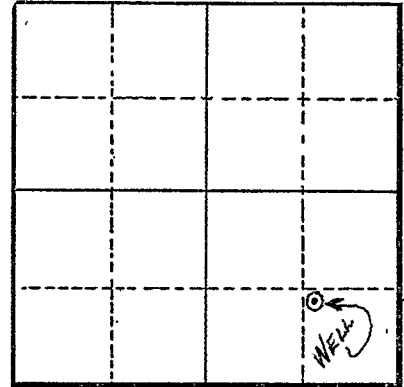

Section 35

Altitude at well 138'

TYPE OF WELL: Drilled Date Constructed 1945

Depth drilled 60' Depth cased 60'

### CASING RECORD:

8" from 8 to 60 ft.

### FINISH:

Mills knife perforations - Depths of slotting unknown

### AQUIFERS:

Sediments

### WATER LEVEL:

10' May, 1945

PUMPING EQUIPMENT: Type Cornell 2 1/2" Cent. H.P. 15

Capacity 200 G.P.M.

### WELL TESTS:

Drawdown 20 ft. after hours 200 G.P.M.

Drawdown 31 ft. after hours 250 G.P.M.

USE OF WATER Irrigation Temp. °F. 19

SOURCE OF INFORMATION GR Record

DRILLER or DIGGER Chester Pugh

### ADDITIONAL DATA:

Log N.A. Water Level Measurements Chemical Analysis Aquifer Test

### REMARKS:

Irrigation of 35 acres.