

STATE ENGINEER
Salem, Oregon

M 1215490

Well Record

STATE WELL NO. 6/3W - 36B
COUNTY MARION
APPLICATION NO. GR-2043

OWNER: Dona (Andal) Walker


MAILING ADDRESS: 915 Evans Ave.

LOCATION OF WELL: Owner's No.

CITY AND STATE: Salem, Oregon

NW 1/4 NE 1/4 Sec. 36 T. 6 N. S. R. 3 W., W.M.

Bearing and distance from section or subdivision corner 85.0' E. and 485' S.

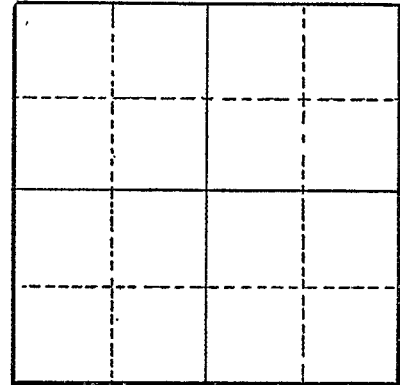

Section

Altitude at well

TYPE OF WELL: Drilled Date Constructed 1955

Depth drilled 80 Depth cased 80

CASING RECORD:

8-inch

FINISH:

Perforation from 44 to 79

AQUIFERS:

Sand and gravel

WATER LEVEL:

15-feet

PUMPING EQUIPMENT: Type Jacuzzi Jet H.P. 5
Capacity 100 G.P.M.

WELL TESTS:

Drawdown	70	ft. after	hours	Pumping	350	G.P.M.
Drawdown	58	ft. after	hours	Pumping	300	G.P.M.

USE OF WATER Irrigation Temp. °F. 19

SOURCE OF INFORMATION GR-1969

DRILLER or DIGGER

ADDITIONAL DATA:

Log ^X Water Level Measurements Chemical Analysis Aquifer Test

REMARKS:

Fine Silt	41	41
Sand and gravel, cemented	36	77
Gravel, loose	3	80