

STATE ENGINEER
Salem, Oregon

5997
MARI

Well Record

STATE WELL NO. 6/3W-36B
COUNTY Marion
APPLICATION NO. GR-1493

GR- 1443

OWNER: Harry Heth


MAILING ADDRESS: 5910 Quinaby Rd.

LOCATION OF WELL: Owner's No.

CITY AND STATE: Salem, Oregon

NW 1/4 NE 1/4 Sec. 36 T. 6 S., R. 3 W., W.M.

Bearing and distance from section or subdivision corner 700' E. & 1200' S. from NE 1/4 cor. Sec. 36

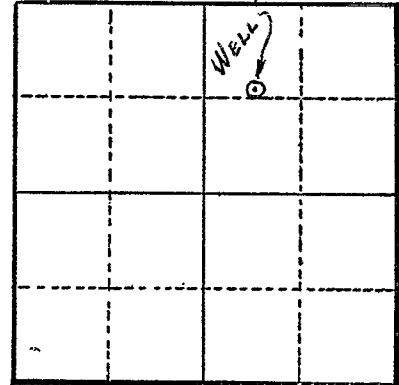

Section 36

Altitude at well

TYPE OF WELL: Drilled Date Constructed 1946

Depth drilled 61' Depth cased 61'

CASING RECORD:

6"

FINISH:

AQUIFERS:

WATER LEVEL:

21'

PUMPING EQUIPMENT: Type Jacuzzi jet H.P. 3
Capacity 42 G.P.M.

WELL TESTS:

Drawdown ft. after hours G.P.M.

Drawdown ft. after hours G.P.M.

USE OF WATER Irrigation Temp. °F. 19

SOURCE OF INFORMATION GR Record

DRILLER or DIGGER

ADDITIONAL DATA:

Log N.A. Water Level Measurements Chemical Analysis Aquifer Test

REMARKS:

Irrigation of 5 acres.