

STATE ENGINEER
Salem, Oregon

MAR 5 50/

Well Record

STATE WELL NO. 6/3W-36D(1)
COUNTY Marion
APPLICATION NO. GR-328

OWNER: Lewis M. Mayers MAILING ADDRESS: 5980 McLeod

LOCATION OF WELL: Owner's No. CITY AND STATE: Salem, Oregon


NW 1/4 NW 1/4 Sec. 36 T. 6 N. S., R. 3 E. W., W.M.

Bearing and distance from section or subdivision corner 11.5 chains East and 14.635 chains South of NW Corner, S. C. Rugh DLC

Altitude at well 148 feet interpolated

TYPE OF WELL: Drilled Date Constructed June 5, 1944

Depth drilled 65.5 feet Depth cased 65.5 feet

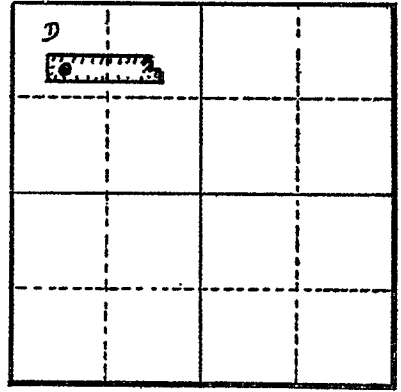

Section 36

CASING RECORD:

8-inch casing set from 10 to 65.5 feet

FINISH:

Perforated from 42 to 56 feet
60 to 65 feet

AQUIFERS:

unk

WATER LEVEL:

22 feet below land surface

PUMPING EQUIPMENT: Type Jacuzzi 4" Centrifugal H.P. 5
Capacity G.P.M.

WELL TESTS:

Drawdown ft. after hours G.P.M.
Drawdown ft. after hours G.P.M.

USE OF WATER Irrigation 6.89 Temp. °F., 19

SOURCE OF INFORMATION GR-310

DRILLER or DIGGER Clements, Route 1, Gervais, Oregon

ADDITIONAL DATA:

Log no Water Level Measurements Chemical Analysis Aquifer Test

REMARKS: