

STATE ENGINEER
Salem, Oregon

M. R. # 502

Well Record

STATE WELL NO. 6/3W-36D(2)
COUNTY Marion
APPLICATION NO. GR-339

OWNER: Guy H. Smith and Golda J. Smith


MAILING ADDRESS: 5955 McLeod

LOCATION OF WELL: Owner's No.

CITY AND STATE: Salem, Oregon

NW 1/4 NW 1/4 Sec. 36 T. 6 N. S, R. 3 W., W.M.

Bearing and distance from section or subdivision corner 500 feet South and 400 feet East from the NW Corner, Section 36

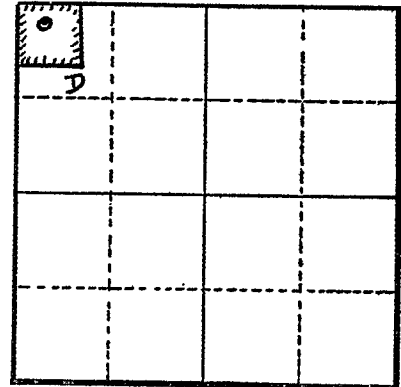

Section 36

Altitude at well 148 feet interpolated

TYPE OF WELL: Drilled Date Constructed 1951

Depth drilled 59 feet Depth cased 59 feet

CASING RECORD:

3-foot pit from 0 to 15 feet
9" casing from 15 to 59 feet

FINISH:

perforated

AQUIFERS:

unk

WATER LEVEL:

15 feet below land surface

PUMPING EQUIPMENT: Type Centrifugal H.P. 5
Capacity 300 G.P.M.

WELL TESTS:

Drawdown ft. after hours G.P.M.
Drawdown ft. after hours G.P.M.

USE OF WATER Irrigation 20.7 Temp. °F. 19

SOURCE OF INFORMATION GR-324

DRILLER or DIGGER Irvin Sears

ADDITIONAL DATA:

Log no Water Level Measurements Chemical Analysis Aquifer Test

REMARKS: