

STATE ENGINEER
Salem, Oregon

MAR 5503

Well Record


STATE WELL NO. 6/3W-36E
COUNTY Marion
APPLICATION NO. GR-3692

OWNER: Stella J. Evenhus
MAILING ADDRESS: 5660 McLead Lane

LOCATION OF WELL: Owner's No. _____
CITY AND STATE: Salem, Oregon

SW 1/4 NW 1/4 Sec. 36 T. 6 N. S. R. 3 W., W.M.

Bearing and distance from section or subdivision
corner 204' N. & 839' E. from W 1/4 cor. Sec. 36

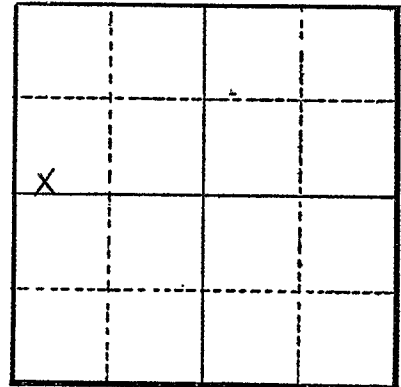

Section 36

Altitude at well _____

TYPE OF WELL: Drilled Date Constructed July, 1955

Depth drilled 46 feet Depth cased 46 feet

CASING RECORD:

4 inch steel casing set to 46 feet

FINISH:

AQUIFERS:

WATER LEVEL:

PUMPING EQUIPMENT: Type Jet H.P. 1 1/2
Capacity _____ G.P.M.

WELL TESTS:

Drawdown _____ ft. after _____ hours _____ G.P.M.
Drawdown _____ ft. after _____ hours _____ G.P.M.

USE OF WATER Irrigation Temp. _____ °F. _____, 19_____

SOURCE OF INFORMATION Well Registration Statement

DRILLER or DIGGER Wymore

ADDITIONAL DATA:

Log _____ Water Level Measurements _____ Chemical Analysis _____ Aquifer Test _____

REMARKS: