

STATE ENGINEER
Salem, Oregon

MAR 25 04

Well Record

STATE WELL NO. 6/3W-36E
COUNTY MARION
APPLICATION NO. GR-2889

OWNER: William H. Beilke


MAILING ADDRESS: 5785 McLeod Lane

LOCATION OF WELL: Owner's No.

CITY AND STATE: Salem, Oregon

SW 1/4 NW 1/4 Sec. 36 T. 6 S., R. 3 W., W.M.

Bearing and distance from section or subdivision corner 713' N. 666' E.

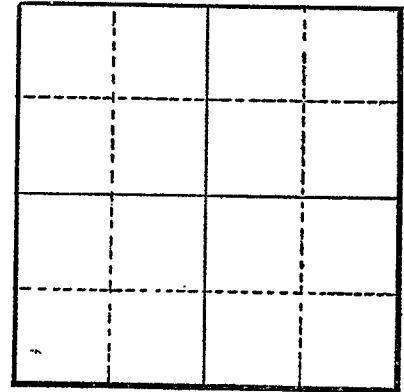

Section

Altitude at well

TYPE OF WELL: drilled Date Constructed

Depth drilled 90' Depth cased

CASING RECORD:

7-inch

FINISH:

AQUIFERS:

WATER LEVEL:

PUMPING EQUIPMENT: Type Shasta Jet H.P. 1
Capacity 35 G.P.M.

WELL TESTS:

Drawdown ft. after hours G.P.M.
Drawdown ft. after hours G.P.M.

USE OF WATER irrigation Temp. °F., 19

SOURCE OF INFORMATION GR-2718

DRILLER or DIGGER

ADDITIONAL DATA:

Log Water Level Measurements Chemical Analysis Aquifer Test

REMARKS: