

STATE ENGINEER
Salem, Oregon


MARION 5509 Well Record

STATE WELL NO. 6/3W-36F
COUNTY Marion
APPLICATION NO. GR-872

OWNER: Ed Sproed
MAILING ADDRESS: 1997 Tepper Lane

LOCATION OF WELL: Owner's No.
CITY AND STATE: Salem, Oregon

SE 1/4 NW 1/4 Sec. 36 T. 6 N. S., R. 3 W., W.M.
Bearing and distance from section or subdivision
corner 1272 feet South and 1576 feet East
from NW Corner, Section 36

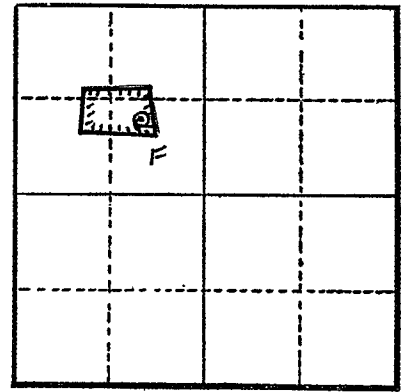

Altitude at well

TYPE OF WELL: Drilled Date Constructed 1951
Depth drilled 80 feet Depth cased 70 feet

Section 36

CASING RECORD:

8-inch steel casing 0 to 70 feet

FINISH:

perforated 40 to 70 feet

AQUIFERS:

WATER LEVEL:

20 feet

PUMPING EQUIPMENT: Type Turbine H.P. 15
Capacity 275 G.P.M.

WELL TESTS:

Drawdown 40 ft. after 260 hours G.P.M.
Drawdown ft. after hours G.P.M.

USE OF WATER Irrigation Temp. °F. 19

SOURCE OF INFORMATION GR-845

DRILLER or DIGGER

ADDITIONAL DATA:

Log na Water Level Measurements Chemical Analysis Aquifer Test

REMARKS: